



not be reproduced, copied, loaned, exhibited, or used in any other way, except by written consent from PARSONS to the borrower.

This document and the design it covers are the property of PARSONS. They are loaned only with the borrower's expressed written agreement that they will

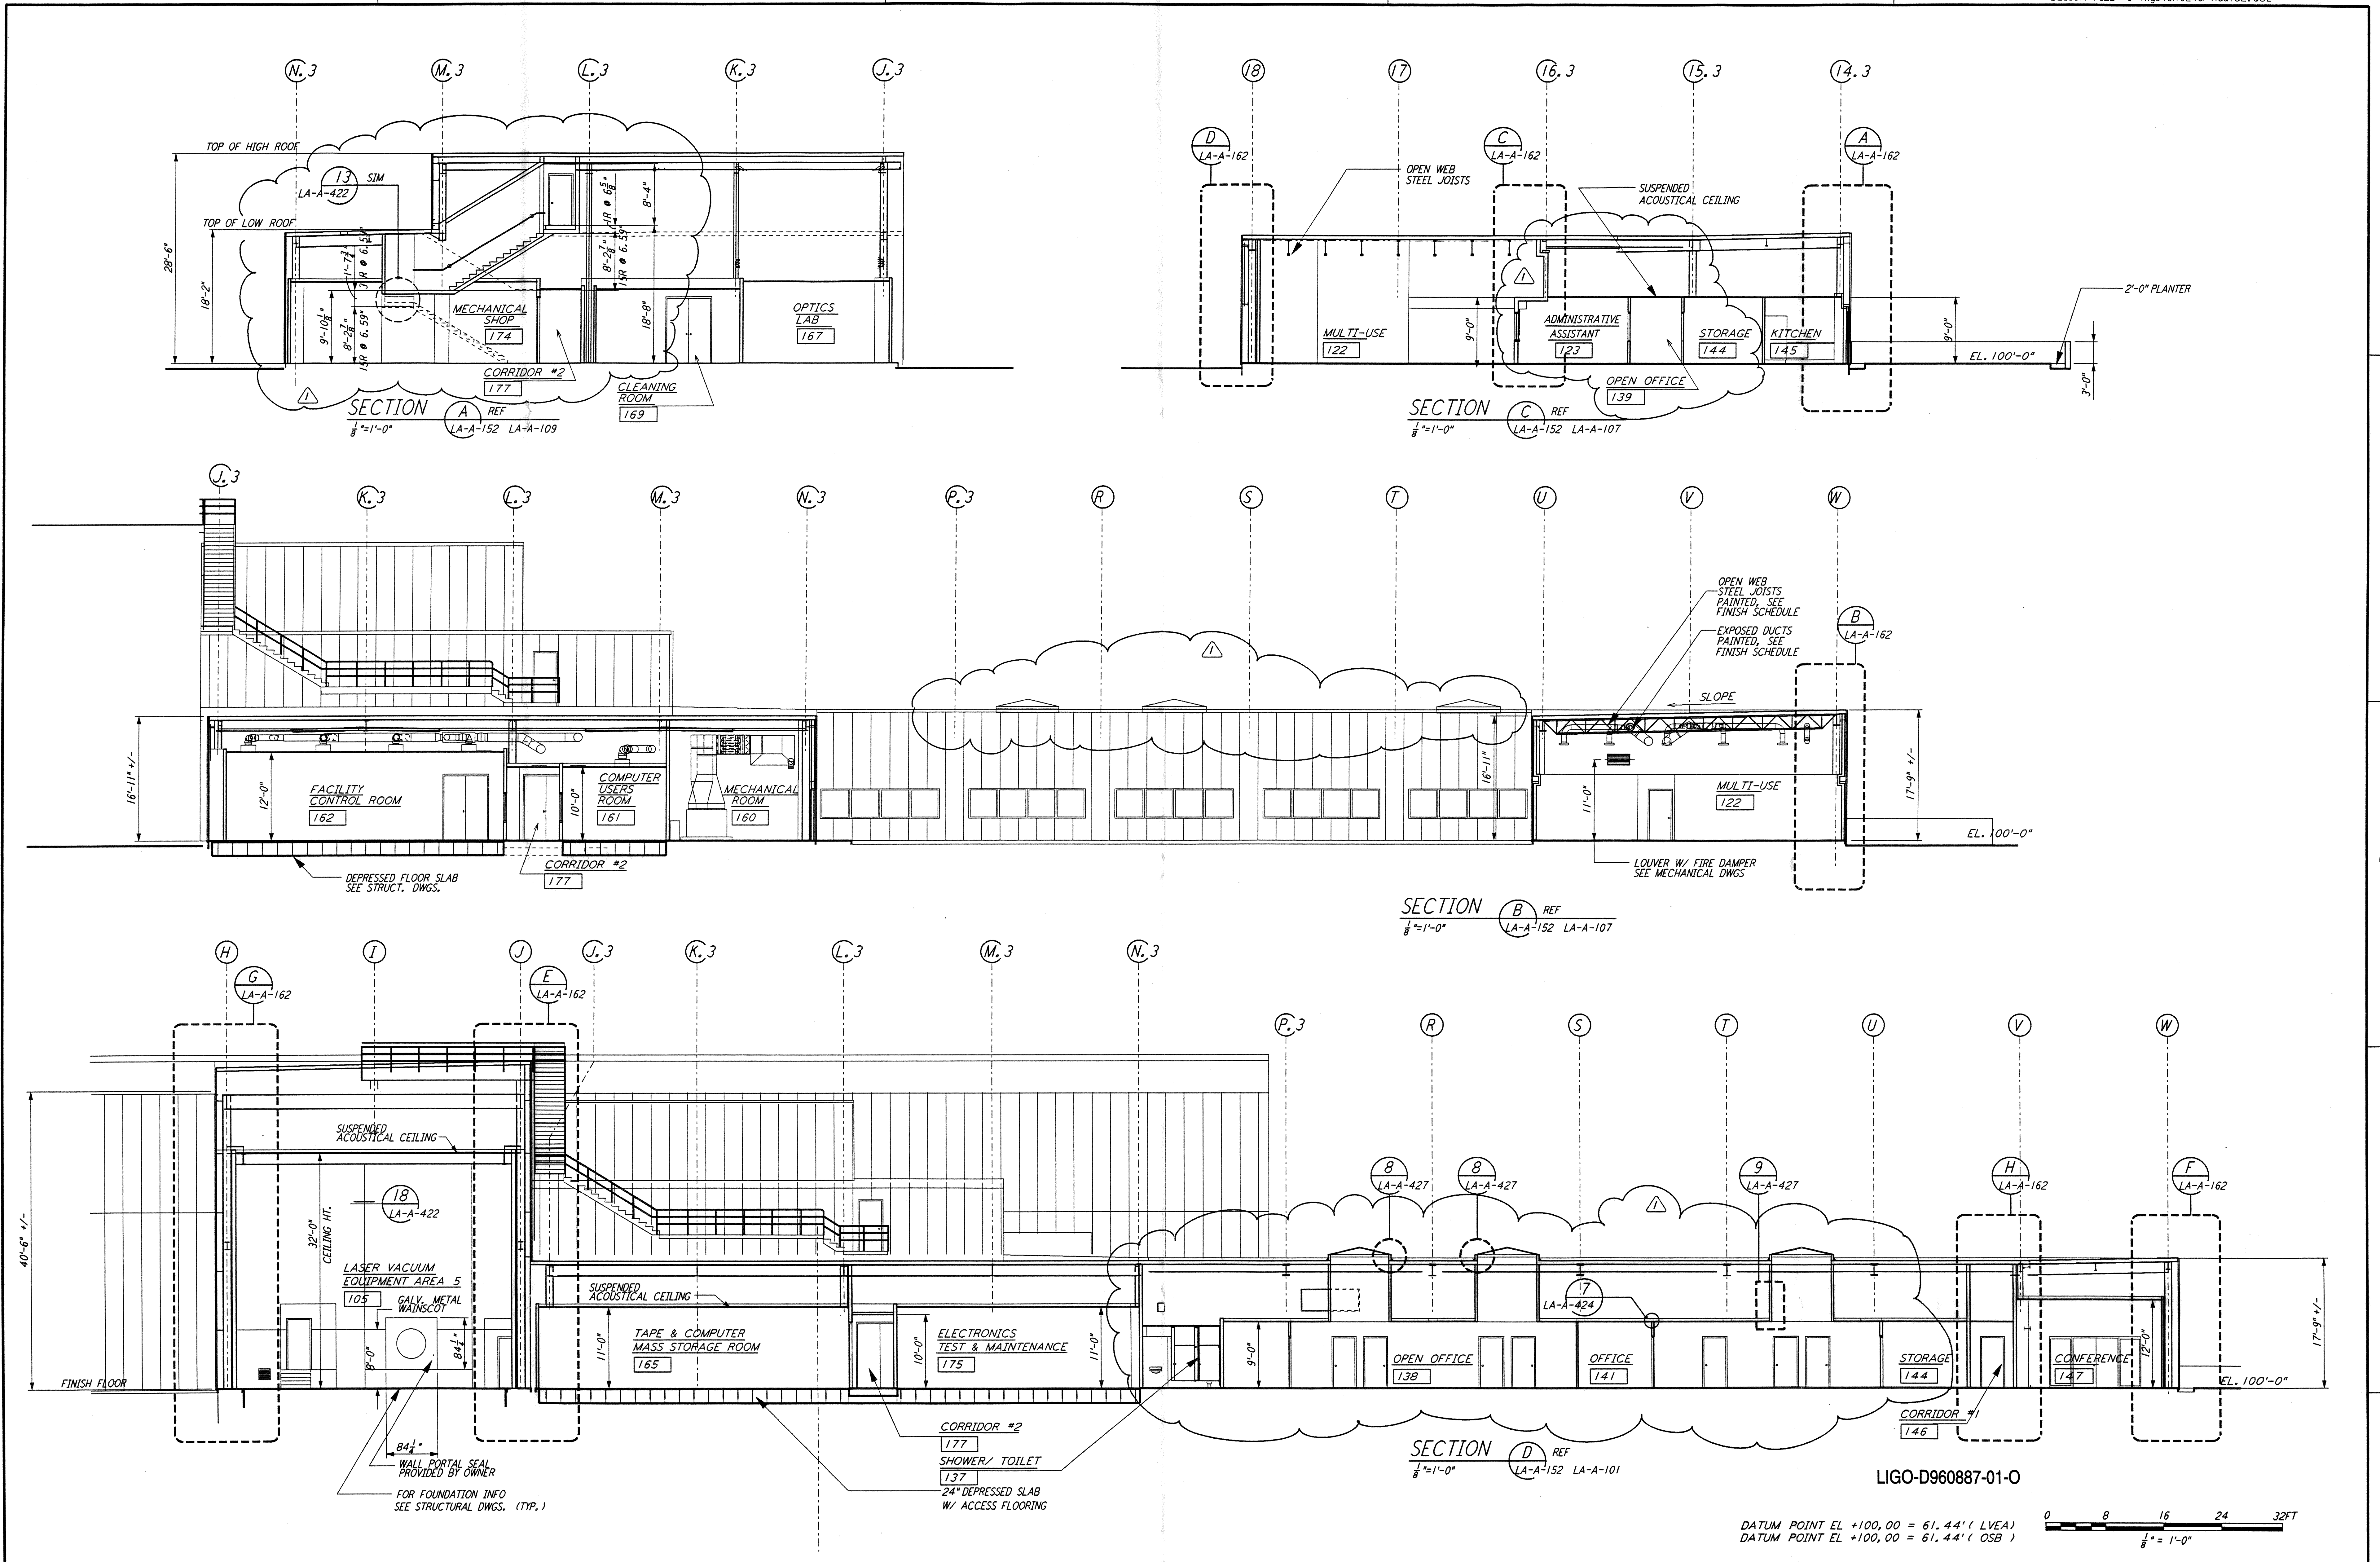

NO.	DATE	BY	CHKD	ENGR	PROJ	REVISION	DESCRIPTION
1	2-28-97	CKT	TB	AK	TDM	OSB	REVISION

ISSUED FOR CONSTRUCTION	DATE
DRAWN	11-15-96
CHECKED	11-15-96
ENGINEER	11-15-96
PROJ	11-15-96

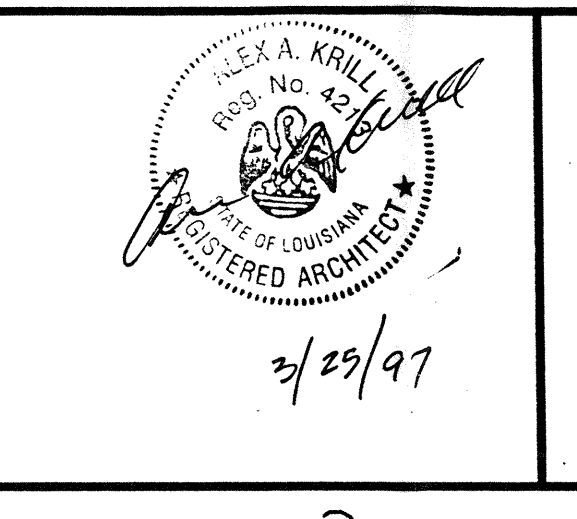

**PARSONS**  
 100 WEST WALNUT STREET  
 PASADENA, CALIFORNIA

**LIGO**  
 CALIFORNIA INSTITUTE OF TECHNOLOGY  
 MASSACHUSETTS INSTITUTE OF TECHNOLOGY

LIGO-D960887-01-O

DATUM POINT EL +100.00 = 61.44' (LVEA)  
 DATUM POINT EL +100.00 = 61.44' (OSB)

SCALE: AS NOTED  
 CONTRACT NUMBER: PPI50969  
 PROJECT NUMBER: 8094

TITLE: ARCHITECTURAL CORNER STATION LVEA & OSB SECTIONS SHEET 2

SHEET NUMBER: **LA-A-152**

LUG Mod 18 12/05/97 1441 CAD/PT 55733302 J:\VLS\WORK\Y\JOB\VIB\OSB2.PIT