This document and the design it covers are the property of **PARSONS**. They are loaned only with the borrower's expressed written agreement that they will not be reproduced, copied, loaned, exhibited, or used in any other way, except by written consent from **PARSONS** to the borrower.

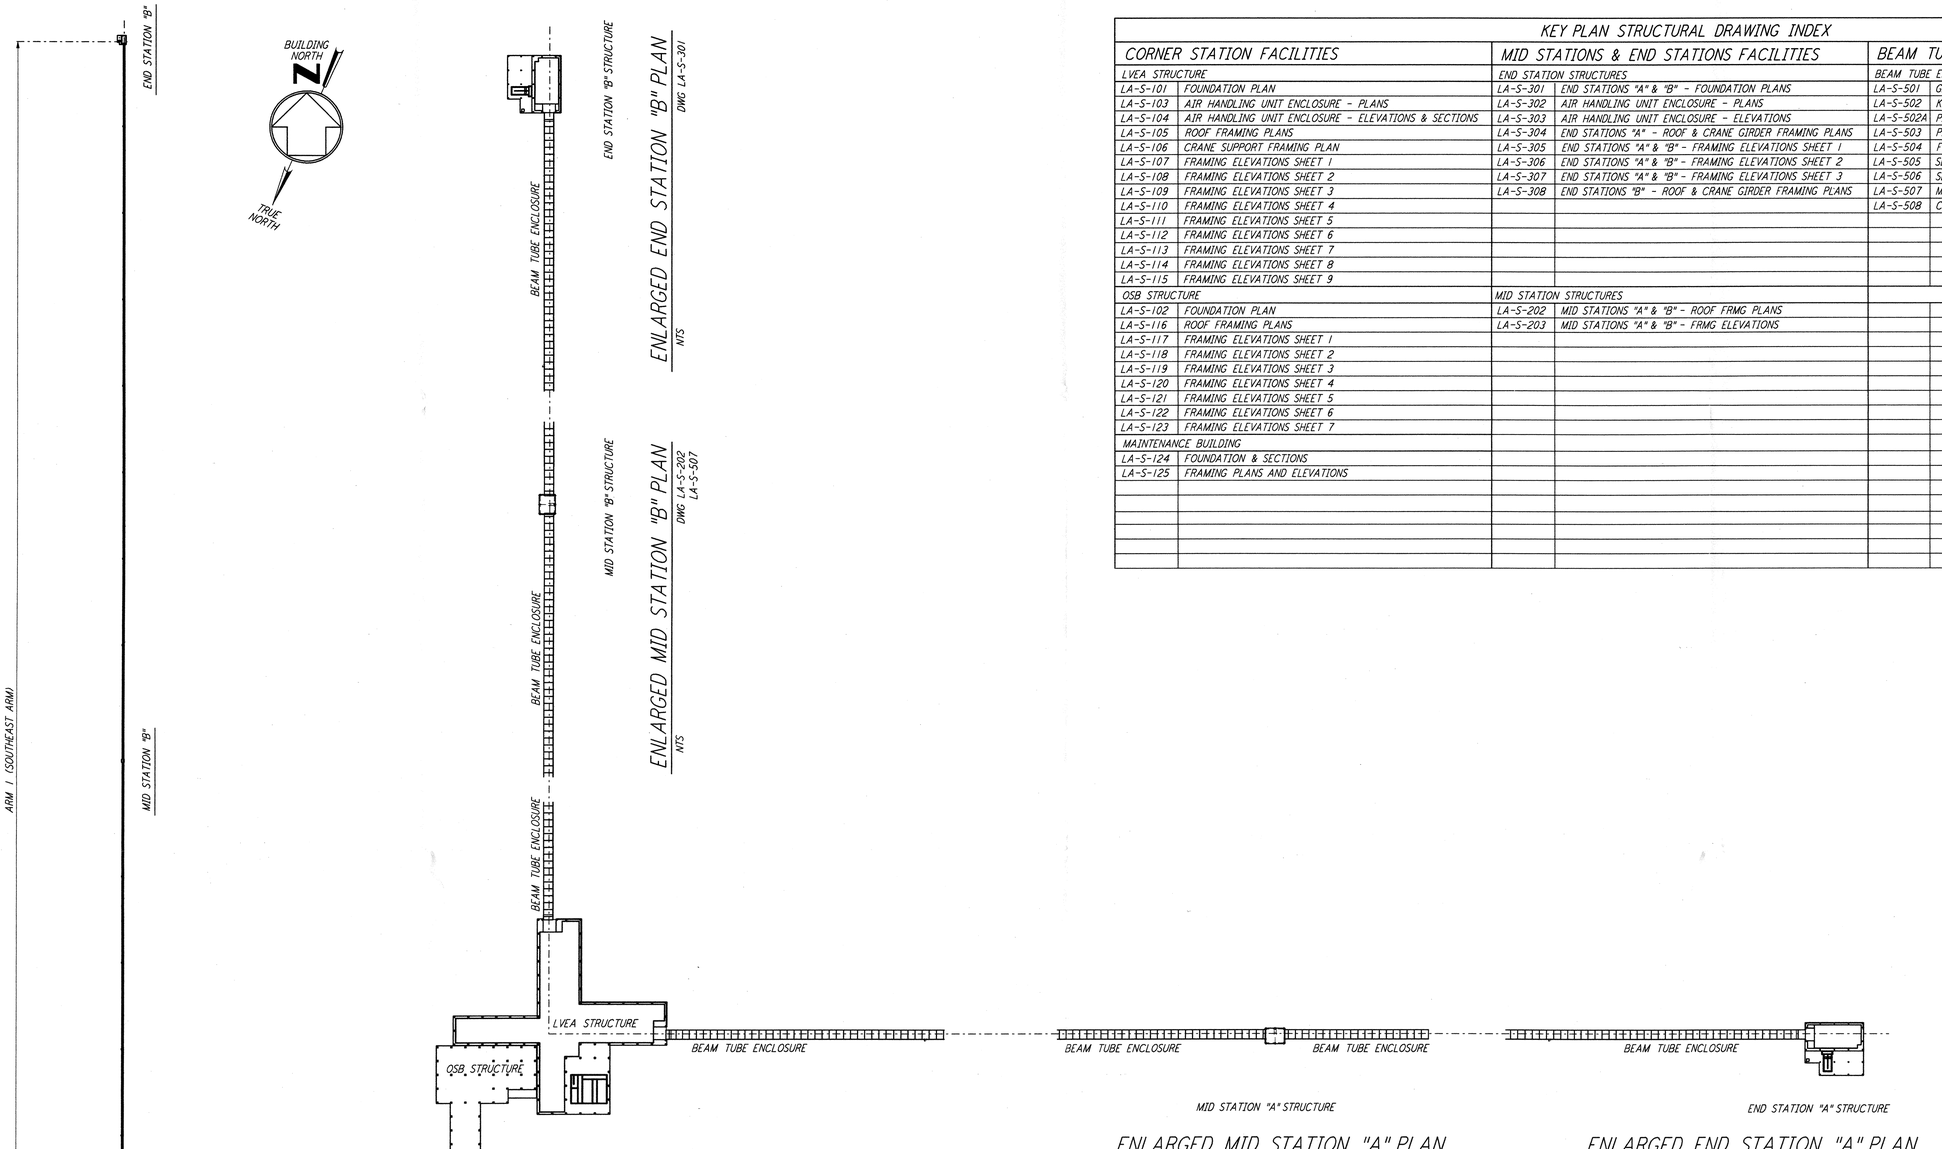

KEY PLAN STRUCTURAL DRAWING INDEX

CORNER STATION FACILITIES		MID STATIONS & END STATIONS FACILITIES		BEAM TUBE ENCLOSURE	
LVEA STRUCTURE		END STATION STRUCTURES		BEAM TUBE ENCLOSURE STRUCTURE	
LA-S-101	FOUNDATION PLAN	LA-S-301	END STATIONS "A" & "B" - FOUNDATION PLANS	LA-S-501	GENERAL NOTES, ABBRREVIATIONS & LEGEND
LA-S-103	AIR HANDLING UNIT ENCLOSURE - PLANS	LA-S-302	AIR HANDLING UNIT ENCLOSURE - PLANS	LA-S-502	KEY PLAN & PARTIAL ENLARGED PLANS
LA-S-104	AIR HANDLING UNIT ENCLOSURE - ELEVATIONS & SECTIONS	LA-S-303	AIR HANDLING UNIT ENCLOSURE - ELEVATIONS	LA-S-502A	PARTIAL ENLARGED PLANS
LA-S-105	ROOF FRAMING PLANS	LA-S-304	END STATIONS "A" - ROOF & CRANE GIRDER FRAMING PLANS	LA-S-503	PLANS, SECTIONS & DETAILS
LA-S-106	CRANE SUPPORT FRAMING PLAN	LA-S-305	END STATIONS "A" & "B" - FRAMING ELEVATIONS SHEET 1	LA-S-504	FOUNDATION KEY PLAN & PARTIAL ENLARGED PLANS
LA-S-107	FRAMING ELEVATIONS SHEET 1	LA-S-306	END STATIONS "A" & "B" - FRAMING ELEVATIONS SHEET 2	LA-S-505	SECTIONS & DETAILS SHEET 1
LA-S-108	FRAMING ELEVATIONS SHEET 2	LA-S-307	END STATIONS "A" & "B" - FRAMING ELEVATIONS SHEET 3	LA-S-506	SECTIONS & DETAILS SHEET 2
LA-S-109	FRAMING ELEVATIONS SHEET 3	LA-S-308	END STATIONS "B" - ROOF & CRANE GIRDER FRAMING PLANS	LA-S-507	MID STATIONS "A" & "B" - FOUNDATION PLANS
LA-S-110	FRAMING ELEVATIONS SHEET 4			LA-S-508	CONCRETE SLAB & JOINT DETAILS
LA-S-111	FRAMING ELEVATIONS SHEET 5				
LA-S-112	FRAMING ELEVATIONS SHEET 6				
LA-S-113	FRAMING ELEVATIONS SHEET 7				
LA-S-114	FRAMING ELEVATIONS SHEET 8				
LA-S-115	FRAMING ELEVATIONS SHEET 9				
OSB STRUCTURE		MID STATION STRUCTURES			
LA-S-102	FOUNDATION PLAN	LA-S-202	MID STATIONS "A" & "B" - ROOF FRMG PLANS		
LA-S-116	ROOF FRAMING PLANS	LA-S-203	MID STATIONS "A" & "B" - FRMG ELEVATIONS		
LA-S-117	FRAMING ELEVATIONS SHEET 1				
LA-S-118	FRAMING ELEVATIONS SHEET 2				
LA-S-119	FRAMING ELEVATIONS SHEET 3				
LA-S-120	FRAMING ELEVATIONS SHEET 4				
LA-S-121	FRAMING ELEVATIONS SHEET 5				
LA-S-122	FRAMING ELEVATIONS SHEET 6				
LA-S-123	FRAMING ELEVATIONS SHEET 7				
MAINTENANCE BUILDING					
LA-S-124	FOUNDATION & SECTIONS				
LA-S-125	FRAMING PLANS AND ELEVATIONS				

REFERENCES

DRAWING NO.	DESCRIPTION

REVISIONS

NO.	DATE	BY	CHKD	ENGR	PROJ	DESCRIPTION
1	08-07-98	WA				ISSUED FOR AS-BUILT

ISSUED FOR CONSTRUCTION		
DRAWN	MCS	11-15-96
CHECKED	DDM	11-15-96
ENGINEER	BP	11-15-96
PROJ	TDM	11-15-96

AS-BUILT DRAWINGS

PARSONS
100 WEST WALNUT STREET
PASADENA, CALIFORNIA

LIGO
CALIFORNIA INSTITUTE OF TECHNOLOGY
MASSACHUSETTS INSTITUTE OF TECHNOLOGY

LASER INTERFEROMETER
GRAVITATIONAL-WAVE OBSERVATORY
SITE NO. 2 - LIVINGSTON, LOUISIANA

TITLE: **STRUCTURAL KEY PLAN**

SCALE	CONTRACT NUMBER	PROJECT NUMBER
NONE	PP150969	8094

SHEET NUMBER: **LA-S-010**
REVISIONS: 1

LIGO-D960916-01-O

LIGOLAF.BDR