This document and the design it covers are the property of **PARSONS**. They are loaned only with the borrower's expressed written agreement that they will not be reproduced, copied, loaned, exhibited, or used in any other way, except by written consent from **PARSONS** to the borrower.

DATE: 08/14/98 TIME: 13:06:58
DESIGN FILE: I:\ligo\site2\st\las105.dgz

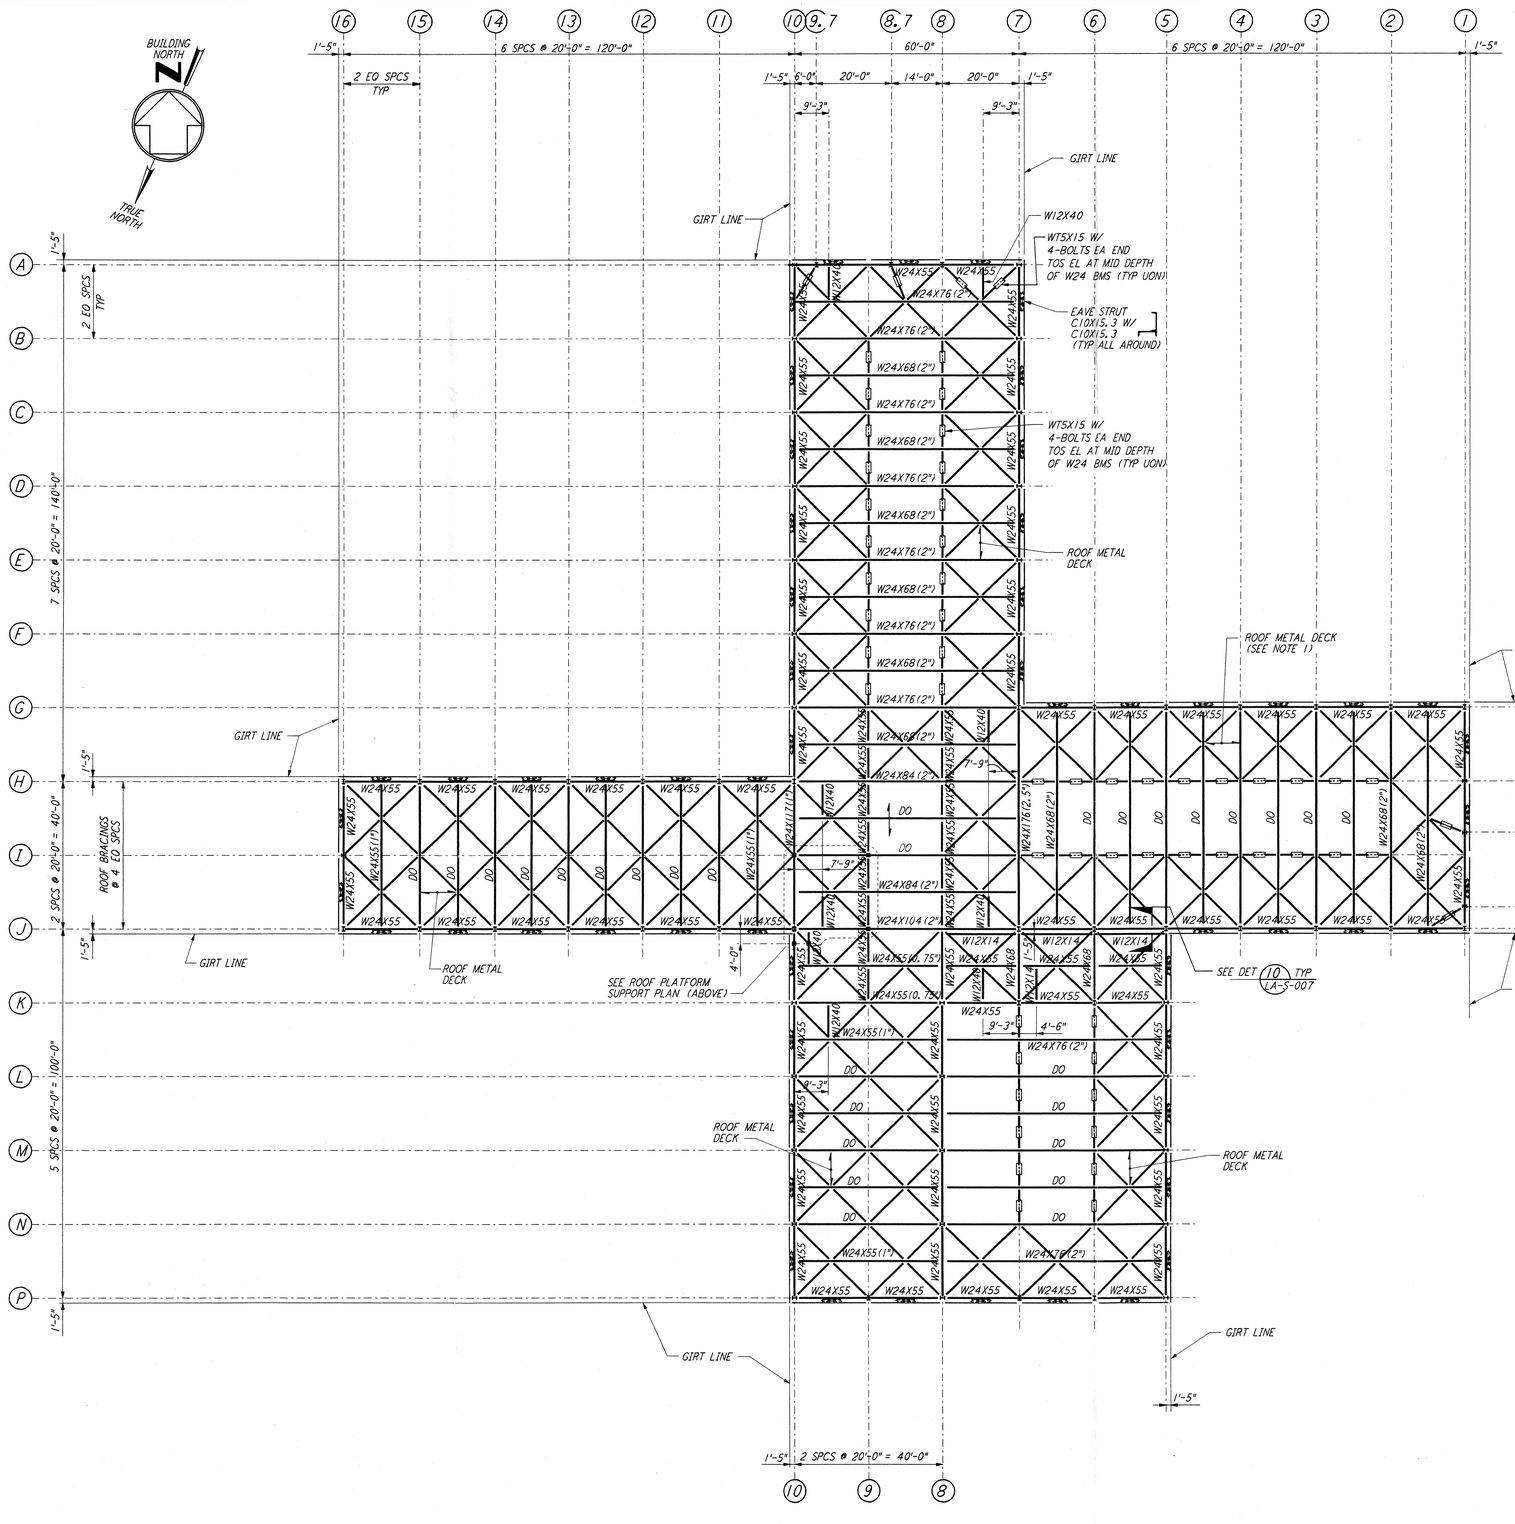

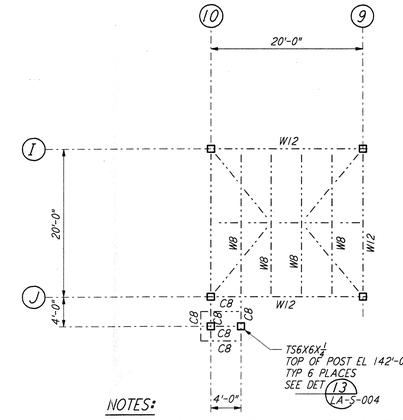

NOTES:
1. PLATFORM SHALL BE DESIGN AND SUPPLIED BY CONTRACTOR. FOR INFORMATION NOT SHOWN SEE ARCHITECTURAL DWGS.
2. FOR SUPPORT POSTS, SEE STRUCTURAL FRAMING ELEVATIONS.

ROOF PLATFORM SUPPORT PLAN

1/8" = 1'-0"

NOTES:
1. FOR GENERAL NOTES SEE DRAWING LA-S-001.
2. NUMBER IN PARENTHESIS FOLLOWING MEMBER SIZE FOR ROOF BEAMS WITH 40 FEET OR 60 FEET SPAN INDICATES REQUIRED CAMBER IN INCHES.
3. FOR BEAM TO BEAM CONNECTIONS, SEE DETAIL 3 TYP UON LA-S-005
4. FOR BEAM TO COLUMN CONNECTIONS, SEE DETAILS 6 LA-S-004 & 4 TYP UON LA-S-007
5. FOR HORIZONTAL BRACING CONNECTIONS, SEE DETAILS 11 LA-S-006, 12 LA-S-006 & 13 LA-S-006

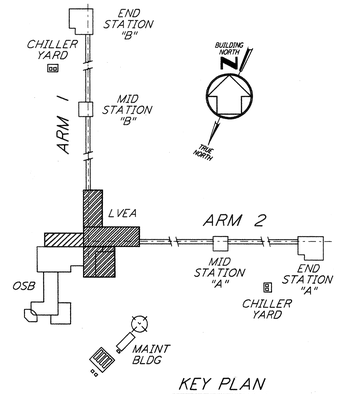

KEY PLAN

0 8 16 24 32 40 48 56 64FT
1/16" = 1'-0"

LIGO-D960921-01-O

REFERENCES		REVISIONS							
DRAWING NO.	DESCRIPTION	NO.	DATE	BY	CHKD	ENGR	PROJ	DESCRIPTION
		1	08-07-98	WA				ISSUED FOR AS-BUILT

ISSUED FOR CONSTRUCTION		
DRAWN	MCS	11-15-96
CHECKED	DDM	11-15-96
ENGINEER	BP	11-15-96
PROJ	TDM	11-15-96

AS-BUILT DRAWINGS

PARSONS
100 WEST WALNUT STREET
PASADENA, CALIFORNIA

LIGO
CALIFORNIA INSTITUTE OF TECHNOLOGY
MASSACHUSETTS INSTITUTE OF TECHNOLOGY

LASER INTERFEROMETER GRAVITATIONAL-WAVE OBSERVATORY
SITE NO. 2 - LIVINGSTON, LOUISIANA

TITLE: STRUCTURAL CORNER STATION LVEA ROOF FRAMING PLAN

SCALE	CONTRACT NUMBER	PROJECT NUMBER
AS NOTED	PP150969	8094

SHEET NUMBER: LA-S-105
REVISIONS: 1

LIGOLAF.BDR