This document and the design it covers are the property of **PARSONS**. They are loaned only with the borrower's expressed written agreement that they will not be reproduced, copied, loaned, exhibited, or used in any other way, except by written consent from **PARSONS** to the borrower.

DATE: 02/25/97 TIME: 12:46:54
DESIGN FILE: I:\ligo\site2\st\las121.dgz

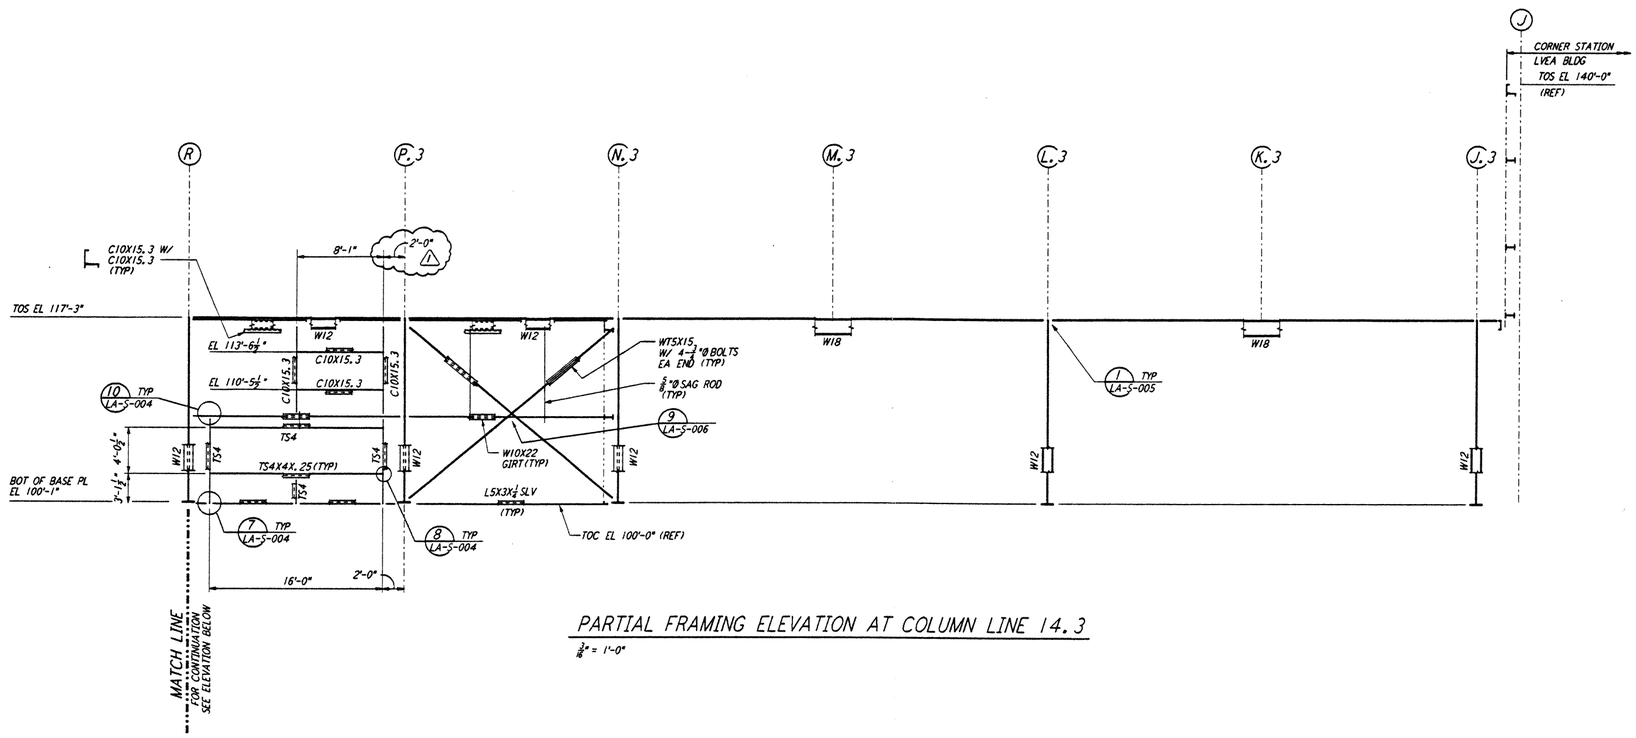

PARTIAL FRAMING ELEVATION AT COLUMN LINE 14.3

3/8" = 1'-0"

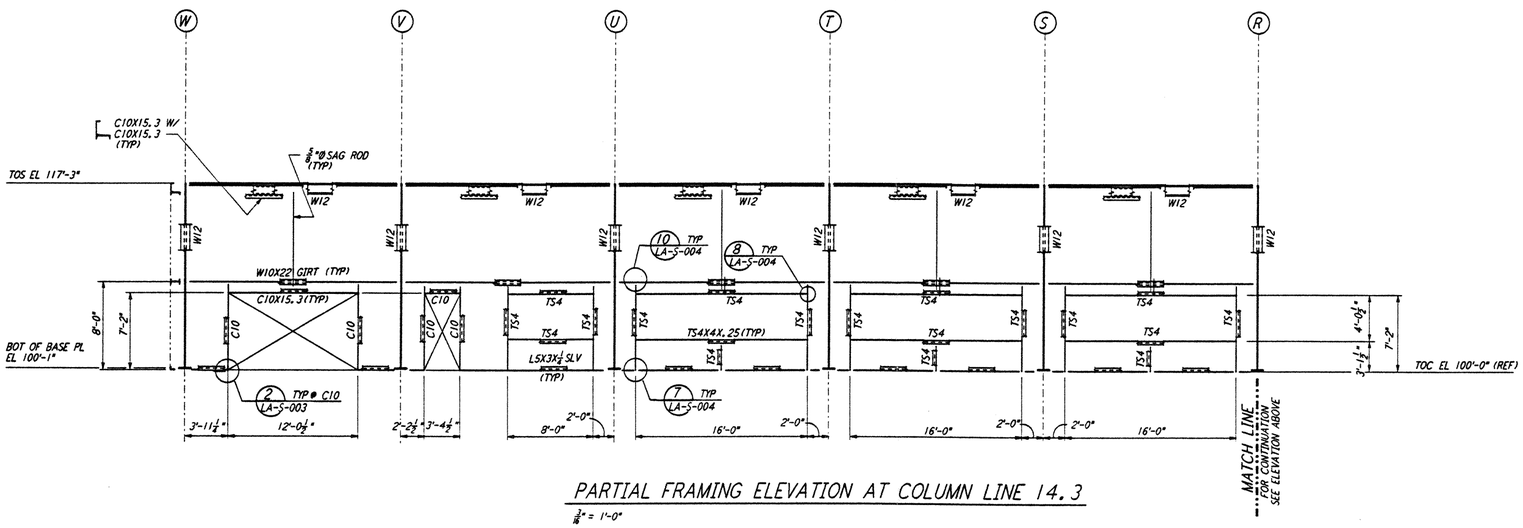

PARTIAL FRAMING ELEVATION AT COLUMN LINE 14.3

3/8" = 1'-0"

NOTES:

1. FOR GENERAL NOTES, ABBREVIATIONS AND SYMBOLS SEE DRAWING LA-S-001.
2. FOR CHANNEL, GIRT AND EAVE STRUT CONNECTION DETAILS SEE DRAWING LA-S-005.
3. FOR W BEAM TO COLUMN WEB/FLANGE CONNECTIONS, SEE DETAILS 6 LA-S-004, 3 LA-S-007 & 4 LA-S-007 TYPICAL UNLESS OTHERWISE NOTED.
4. FOR BASE ANGLE (L5X3) CONNECTIONS, SEE SECTION A LA-S-003.
5. FOR VERT BRCG CONNECTIONS SEE 2 LA-S-006 8 LA-S-006 1 LA-S-007 2 LA-S-007 TYP UON.

0 4 8 12 16 20FT

3/8" = 1'-0"

LIGO-D960937-01-O

REFERENCES		REVISIONS						
DRAWING NO.	DESCRIPTION	NO.	DATE	BY	CHKD	ENGR	PROJ	DESCRIPTION
		1	2-28-97	RM	AB	[illegible]		REV DIM AT ELEV LN 14.3

ISSUED FOR CONSTRUCTION		
DRAWN	MCS	11-15-96
CHECKED	DDM	11-15-96
ENGINEER	BP	11-15-96
PROJ	TDM	11-15-96

STATE OF LOUISIANA — JOHN A. LAWRENCE — 23797 — PROFESSIONAL ENGINEER IN CIVIL ENGINEERING — 2-27-97

PARSONS
100 WEST WALNUT STREET
PASADENA, CALIFORNIA

LIGO
CALIFORNIA INSTITUTE OF TECHNOLOGY
MASSACHUSETTS INSTITUTE OF TECHNOLOGY

LASER INTERFEROMETER GRAVITATIONAL-WAVE OBSERVATORY
SITE NO. 2 - LIVINGSTON, LOUISIANA

TITLE: STRUCTURAL CORNER STATION OSB FRAMING ELEVATIONS SHEET 5

SCALE: AS NOTED | CONTRACT NUMBER: PP150969 | PROJECT NUMBER: 8094

SHEET NUMBER: LA-S-121 | REVISIONS: 1

LIGOLAF.BDR

Tue Feb 25 12:46:23 1997 J:\PCPLOTS\MULTI\SVR8BZ\S1\2MAP.PRF
Tue Feb 25 12:46:23 1997 J:\PCPLOTS\MULTI\SVR8BZ\S1\2MAP.PRF