DATE: 10/07/98 TIME: 16:22:29
DESIGN FILE: I:\ligo\site2\st\las401.dgz

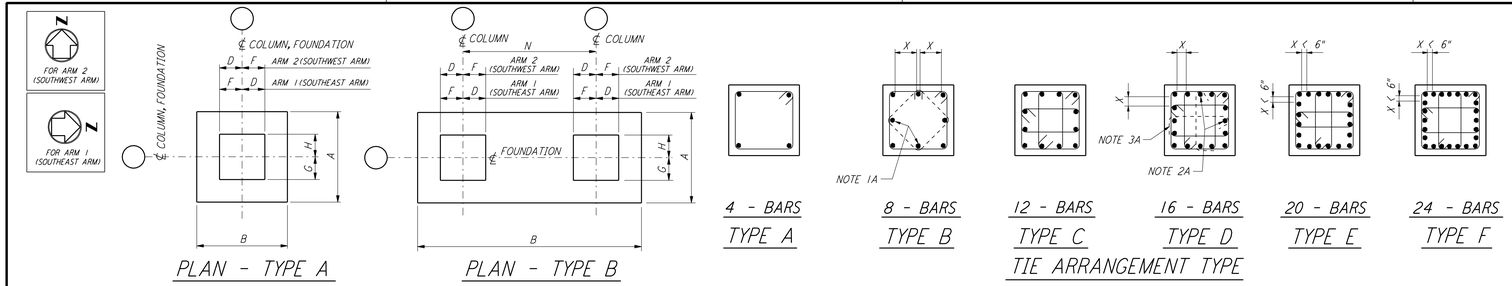

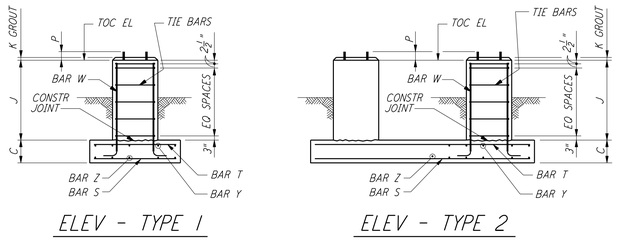

TIE REINFORCEMENT NOTES:

1A. THESE BARS MUST BE TIED AS SHOWN BY DASHED LINES WHEN X DISTANCE IS OVER 6 INCHES.
2A. THESE BARS NEED NOT BE TIED WHEN X DISTANCE IS 6 INCHES OR LESS.
3A. ALTERNATE 90° HOOKS IN COLUMNS.

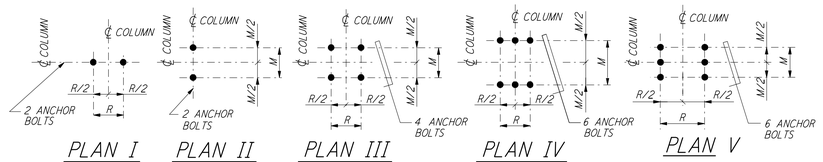

NOTES:

1. CONSTRUCTION SHALL COMPLY WITH ALL THE REQUIREMENTS OF THE GENERAL NOTES ON DRAWING LA-S-001.
2. THE BAR SPACING IS BASED ON CENTER TO CENTER OF TIE SET.
3. FOR ANCHOR BOLT DETAILS SEE DRAWING LA-S-003.
4. FOUNDATION SCHEDULE SHOWN IS FOR ONE (1) BUILDING ONLY. TWO (2) BUILDINGS REQUIRED.

FOUNDATION		TOP OF CONC EL	FOUNDATION TYPE		DIMENSIONS												ANCHOR BOLTS PER PIER						REINFORCING PER FOUNDATION														CONC CY	FDN LOC PLAN	REMARKS
NO OF FDNS REQD	LOCATION		PLAN	ELEV	A	B	C	D	F	G	H	J	K	M	R	N	ANCHOR BOLT PLAN	TYPE	NO PER PIER	SIZE Ø	L	P	BAR S NO	BAR S SIZE	BAR Z NO	BAR Z SIZE	BAR T NO	BAR T SIZE	BAR Y NO	BAR Y SIZE	BAR W NO	BAR W SIZE	TIE BAR TYPE	TIE BAR SIZE	TIE BAR NO REQD			
2	C3, C4	100'-0"	A	1	3'-6"	3'-6"	1'-0"	10"	10"	10"	10"	1'-8"	1"	7"	7"	——	III	2	4	1"	1'-4"	4"	5	#4	5	#4	—	—	—	—	8	#5	B	#4	4	1.3	LA-S-301	
1	D4	100'-0"	A	1	5'-0"	5'-0"	1'-0"	10"	10"	1'-3½"	10"	1'-8"	1"	7"	7"	——	III	2	4	1"	1'-4"	4"	7	#4	7	#4	7	#4	7	#4	8	#6	B	#4	4	1.2	LA-S-301	
1	D5	100'-0"	A	1	5'-0"	5'-0"	1'-0"	10"	1'-3½"	1'-3½"	10"	1'-8"	1"	7"	7"	——	III	2	4	1"	1'-4"	4"	7	#4	7	#4	7	#4	7	#4	8	#6	B	#4	4	1.2	LA-S-301	
2	C1, C2	100'-0"	A	1	15'-0"	8'-0"	2'-0"	1'-3½"	12"	1'-3½"	12"	4'-0"	1"	7"	7"	——	III	2	4	1"	1'-4"	4"	18	#6	10	#6	18	#6	10	#6	8	#7	B	#4	6	9.7	LA-S-301	
1	C5	100'-0"	A	1	15'-0"	8'-0"	2'-0"	12"	1'-3½"	12"	12"	4'-0"	1"	7"	7"	——	III	2	4	1"	1'-4"	4"	18	#6	10	#6	18	#6	10	#6	8	#6	B	#4	6	9.7	LA-S-301	
1	D2	100'-0"	B	2	6'-0"	26'-0"	2'-0"	1'-3½"	12"	1'- 3½"	12"	1'-8"	1"	7"	7"	20'-0"	III	2	4	1"	1'-4"	4"	8	#6	31	#6	8	#6	31	#6	8	#7	B	#4	4	12.2	LA-S-301	
	D3	100'-0"						12"	12"	1'-3½"	12"	1'-8"	1"	7"	7"		III	2	4	1"	1'-4"	4"									8	#6	B	#4	4			
—	A2, A3, B1, B2, B3, B5	100'-0"	—	—	—	—	—	—	—	—	—	—	1"	7"	7"	—	III	2	4	1"	1'-4"	4"	—	—	—	—	—	—	—	—	—	—	—	—	—	—	LA-S-301	FOR ANCHOR BOLTS ONLY
—	A1, A4, A5, B4	100'-0"	—	—	—	—	—	—	—	—	—	—	1"	7"	7"	—	III	2	4	1"	1'-4"	4"	—	—	—	—	—	—	—	—	—	—	—	—	—	—	LA-S-301	FOR ANCHOR BOLTS ONLY
—	A. 1-1, A. 1-5 A. 7-1, A. 7-5	100'-0"	—	—	—	—	—	—	—	—	—	—	1"	7"	7"	—	III	2	4	1"	1'-4"	4"	—	—	—	—	—	—	—	—	—	—	—	—	—	—	LA-S-301	FOR ANCHOR BOLTS ONLY

END STATION STRUCTURES (FOR ARM 1 & ARM 2) SEE NOTE 4

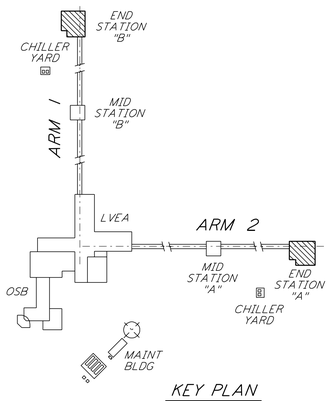

LIGO-D960953-01-O

REFERENCES		REVISIONS						
DRAWING NO.	DESCRIPTION	NO.	DATE	BY	CHKD	ENGR	PROJ	DESCRIPTION
		1	08-07-98	WA				ISSUED FOR AS-BUILT

ISSUED FOR CONSTRUCTION		
DRAWN	MCS	11-15-96
CHECKED	DDM	11-15-96
ENGINEER	BP	11-15-96
PROJ	TDM	11-15-96

AS-BUILT DRAWINGS

PARSONS
100 WEST WALNUT STREET
PASADENA, CALIFORNIA

LIGO
CALIFORNIA INSTITUTE OF TECHNOLOGY
MASSACHUSETTS INSTITUTE OF TECHNOLOGY

LASER INTERFEROMETER GRAVITATIONAL-WAVE OBSERVATORY
SITE NO. 2 - LIVINGSTON, LOUISIANA

TITLE: STRUCTURAL END STATIONS "A" & "B" FOUNDATION SCHEDULE AND DETAILS

SCALE	CONTRACT NUMBER	PROJECT NUMBER
NONE	PP150969	8094

SHEET NUMBER: LA-S-401 REVISIONS: 1

LIGOLAF.BDR

This document and the design it covers are the property of PARSONS. They are loaned only with the borrower's expressed written agreement that they will not be reproduced, copied, loaned, exhibited, or used in any other way, except by written consent from PARSONS to the borrower.

Wed Oct 7 16:21:52 1998 e:\plot\ref\S3-30.ref N:\DUE\ES\E30B2\ST440.PRF