	INPL	JT/OUTPUT	SUMMARY FO	PR AIR HANDLING UI	VIT AH-01 (TYP 2	SYSTEMS)		
CVCTEAA		INPUTS	T	OUTPUTS	SYSTEM FEAT	TURES		
	ANAL	OG	BINARY	DIGITAL ANALOG	ALARMS	PROGRAMS	GENERAL	
	MEASURED	CALCULATED						
SYSTEM, APPARATUS, OR AREA POINT DESCRIPTION	TEMPERATURE PRESSURE RH KW AIR FLOW LEVEL GALLONS	VIBRATIONS KWH ENTHALPY RUN TIME EFFICIENCY WET BULB TEMP	STATUS FIL TER SWOKE FREEZE AIR FLOW METER	OFF-ON OFF-AUTO-ON OFF-HI-LO OPEN-CLOSE MULTI-STAGE MULTI-STAGE VALVE POSITION SET POINT ADJUSTMENT VANE POSITION SCR CONTROL	HI ANALOG LOW ANALOG HI BINARY LOW BINARY PROOF TIME SCHEDULING DEMAND LIMITING	WD WD WT	COLOR GRAPHIC	SUPPLEMENTARY NOTES
OUTSIDE TEMERATURE	•							
OUTSIDE RELATIVE HUMIDITY								
PREHEAT COIL, HC-14		Total Control of the						
PREHEAT COIL, HC-15								
AIR FILTER AF-01 (TYP 2)								2 SENSORS
AIR FILTER AF-02 (TYP 2)	•					•		2 SENSORS
MIXING AIR DAMPER OI								
MIXING AIR DAMPER 02								
COOLING COIL CC-01	•							
COOLING COIL CC-02	•					• •		
SUPPLY FAN SF-01		• •	•			• • •		
SUPPLY FAN SF-02	•	• •	•		• • •	• • •		
SUPPLY AIR TEMP (TYP 2)	•							
SUPPLY AIR RELATIVE HUMIDITY								
ROOM TEMPERATURE (TYPICAL 5 ZONES)	•							
SPACE AVERAGE RELATIVE HUMIDITY	•							
ZONE DUCT HEATER (VEA)						• • •		
ZONE DUCT HEATERS (TYPICAL 5 ZONES)	•					•		
SMOKE DETECTOR (SD-01)						• •		
MIXING AIR TEMP								
·								
AIR COMPRESSORS (TYP 2)	•		•					
TOILET EXHAUST FAN, EF-01								
AIR FLOW DIAGRAM								
HEPA FILTERS								
FLOOR PLANS							•	

		INP	OT/O	UTPU	JT SU	MMAI	77	FOF	? W	ATE	R C	HIL	LEF	RS CH	-01	&	CH	-02	2 (TY	P 2	51	YSTE	MSI)		anna esta alta esta esta esta esta esta esta esta es	
SYSTEM, APPARATUS, OR AREA POINT DESCRIPTION	INPUTS									OUTPUTS						SYSTEM FEATURES												
	ANALOG						BINARY			DIGITAL			ANAL OG		ALARMS			PROGRAMS						GENERAL				
	/	MEASURED CALCULATED			DINAM				DIGITAL			AIVALOG		ALAMO			FROGRAMS									İ		
	TEMPERA TURE PRESSURE	KW AIR FLOW	LEVEL VIBRATIONS CPM	KWH ENTHALPY	RUN TIME EFFICIENCY WET BULB TEMP	STATUS FILTER	SMOKE FREEZE	AIR FLOW METER		OFF-ON OFF-AUTO-ON	OPEN-CLOSE	DAMPER POSITION	VAL VE POSITION	SET POINT ADJUSTMENT VANE POSITION SCR CONTROL	HI ANALOG LOW ANALOG	HI BINARY	PROOF		TIME SCHEDULING	DEMAND LIMITING DUTY CYCLE	START/STOP OPTION ENTHALPY OPTION	SMOKE CNT	ALARM INSTRUCT MAINT WK ORD		COLOR GRAPHIC	COLOR GRAPHIC	SUPPLEMENTARY NOTES	
VATER CHILLER, CH-01			•		•					•			1	•	0 0				•		•		00					
VATER CHILLER, CH-02	•		•		•	•				•				•	• •				•		0		•					
HILLED WATER PUMP, WP-01	•		0			•				•					•		•		•		•							
CHILLED WATER PUMP, WP-02						•				•					•		•		•		•							
HILLED WATER RETURN TEMP	•																											
HILLED WATER SUPPLY TEMP	•																			-								
HILLED WATER BOOSTER PUMP						•				•											•		• •					PUMP BY VE CONTRACTOR
HILLED WATER FLOW DIAGRAM																									•			
CLOOR PLANS																						A			•			

NOTES:

- 1. FOR LEGEND, ABBREVIATIONS AND GENERAL NOTES SEE SHEETS LA-H-001 AND LA-H-002.
- 2. SMOKE DETECTORS WILL BE HARD WIRED TO THE SUPPLY FANS SF-01 & SF-02 MOTOR STARTER TO STOP FANS WHEN SMOKE DETECTED IN THE RETURN AIR STREAM. ALSO SMOKE DETECTORS WILL BE SOFTWARE CONNECTED TO DDC CONTROL PANEL AND THE FACILITY CONTROL ROOM.
- 3. CONTROL SYSTEM SHALL BE STAND ALONE TYPE AND CONNECTED TO THE MAIN CONTROL AND MONITORING SYSTEM AT THE FACILITY CONTROL ROOM IN THE CORNER STATION BUILDING.
- 4. VACUUM EQUIPMENT ROOM WILL BE PROVIDED WITH FOUR TEMPERATURE SENSORS TO CONTROL THE RESPECTIVE DUCT HEATER. SYSTEM MAY AVERAGE THE READING OF THE FOUR ROOM TEMPERATURE SENSORS OR SELECT ANY SENSOR TO CONTROL THE DUCT HEATER.

SEQUENCE OF OPERATION:

I. CHILLED WATER PLANT:

UPON A SIGNAL FROM THE CENTRAL CONTROL SYSTEM THE PACKAGED CONTROLS PROVIDED WITH THE WATER CHILLER WILL PERFORM THE FOLLOWING:

- A. THE LEAD CHILLED WATER PUMP (WP-01) WILL START TO ESTABLISH STEADY WATER FLOW THROUGH THE SYSTEM.
- B. UPON PROOF OF ESTABLISHED WATER FLOW THE LEAD CHILLER (CH-01) WILL START TO MAINTAIN THE LEAVING CHILLED WATER TEMPERATURE SETPOINT (42°F).
- C. THE PACKAGED DDC CONTROLS ON THE WATER CHILLER WILL CYCLE THE REFRIGERATION COMPRESSORS IN SEQUENCE TO MATCH THE SYSTEM THERMAL LOAD.
- D. WHEN THE THERMAL LOAD DROPS BELOW THE MINIMUM OPERATING CAPACITY OF THE WATER CHILLER, THE PACKAGED CONTROL WILL
- ACTIVATE THE HOT GAS BYPASS CYCLE.

 E. PACKAGED CONTROLS WILL RUN SELF DIAGNOSTICS TEST BEFORE STARTING THE REFRIGERATION COMPRESSORS TO PROVE THAT ALL OPERATING CONDITIONS ARE WITHIN THE NORMAL LIMITS.
- F. PACKAGED CONTROLS WILL CONTINUOUSLY MONITOR THE CHILLER
 OPERATION AND REPORT ANY OPERATIONAL OR SAFETY ALARMS TO THE
 OPERATOR COMPUTER IN THE FACILITY CONTROL ROOM. PACKAGED
 CONTROLS WILL AUTOMATICALLY STOP THE MALFUNCTIONING WATER CHILLER
 AND START THE STANDBY CHILLER.
- G. CENTRAL CONTROL SYSTEM WILL ALTERNATE THE LEAD AND STANDBY WATER CHILLERS TO MAINTAIN EQUAL OPERATING PERIODS ON BOTH WATER

II. AIR HANDLING SYSTEM:

CHILLERS.

UPON A SIGNAL FROM THE CENTRAL CONTROL SYSTEM THE LEAD SUPPLY AIR FAN (SF-01) WILL START TO ESTABLISH A STEADY AIR FLOW THROUGH THE SYSTEM. THE DDC CONTROLS WILL PERFORM THE FOLLWING:

- A. MODULATE THE CONTROLLABLE PITCH VANES ON THE SUPPLY AIR FANS TO MAINTAIN THE DESIRED CONSTANT AIR VOLUME FLOW RATE REGARDLESS OF THE SYSTEM STATIC PRESSURE.
- B. THE TEMPERATURE SENSORS LOCATED DOWN STREAM OF THE OUTSIDE AIR PREHEAT COILS WILL BE USED TO CONTROL THE CAPACITY OF THE DUCT ELECTRIC HEATERS TO MAINTAIN THE OUTSIDE AIR DRY BULB TEMPERATURE AT 50°F.
- C. THE TEMPERATURE SENSOR LOCATED DOWN STREAM OF THE COOLING COIL WILL BE USED TO MODULATE THE 3-WAY CONTROL VALVE ON THE CHILLED WATER LOOP TO MAINTAIN THE LEAVING AIR DRY BULB TEMPERATURE AT THE SET POINT (50°F).
- D. THE DDC CONTROLS WILL COMPARE THE SPACE ROOM TEMPERATURE SENSORS AND MODULATE THE FACE AND BYPASS DAMPER BASED ON THE MOST DEMANDING ZONE.
- E. THE ROOM TEMPERATURE SENSORS (TOTAL 4) OF VACUUM EQUIPMENT AREA SHALL BE USED TO MODULATE THE SCR CONTROLS ON THE RESPECTIVE ELECTRIC DUCT HEATER TO MAINTAIN THE ROOM TEMPERATURE SETPOINT (72°F)
- F. THE ROOM TEMPERATURE SENSORS FOR OTHER ROOMS SHALL BE USED TO SEQUENCE THE CAPACITY CONTROL STAGES OF THEIR RESPECTIVE DUCT HEATERS TO MAINTAIN THE ROOM TEMPERATURE SET POINT.
- G. WHEN THE ROOM TEMPERATURE RISES 5 DEGREES F ABOVE THE SETPOINT, THE CONTROL SYSTEM SHALL REPORT AN ALARM SIGNAL TO THE FACILITY CONTROL ROOM.
- H. THE RELATIVE HUMIDITY SENSOR LOCATED IN VACUUM EQUIPMENT ROOM SHALL BE USED TO MONITOR THE SPACE RELATIVE HUMIDITY.
- I. THE SMOKE DUCT DETECTOR IN THE RETURN AIR DUCTS SHALL STOP THE SUPPLY AIR FANS WHEN SMOKE IS DETECTED IN THE RETURN AIR STREAM AND REPORT AN ALARM SIGNAL (AUDIO AND VISIUAL) AT THE FACILITY CONTROL ROOM AND LOCAL CONTROL PANEL.

 THE SPACE DIFFERENTIAL PRESSURE SENSORS SHALL BE USED TO MODULATE THE MOTORIZED CONTROL DAMPERS ON THE RETURN AIR DUCTS AND THE OUTSIDE AIR DUCTS TO MAINTAIN

III. EQUIPMENT START UP:


A. ALL WATER CHILLER SHALL BE SOFT START

THE SPACE PRESSURIZATION AT THE SETPOINT.

- B. THE SUPPLY AIR FANS SF-01 & SF-02 SHALL START AT THE MINIMUM STATIC PRESSURE AND GRADUALLY INCREASE THE SYSTEM STATIC PRESSURE TO MAINTAIN THE DESIRED AIR FLOW RATE.
- C. THE BUILDING PRESSURIZATION SENSORS FOR LVEA AND OSB (LAB AREA) SHALL MODULATE THE MOTORIZED DAMPERS LOCATED ON THE RETURN AIR & OUTSIDE AIR DAMPERS TO START AT 100% RETURN AIR AND GRADUALLY MODULATE THE DAMPERS TO MAINTAIN THE BUILDING PRESSURIZATION SETPOINT.

IV. TOILET EXHAUST FAN:

A. THE TOILET EXHAUST FAN WILL RUN CONTINUOUSLY.

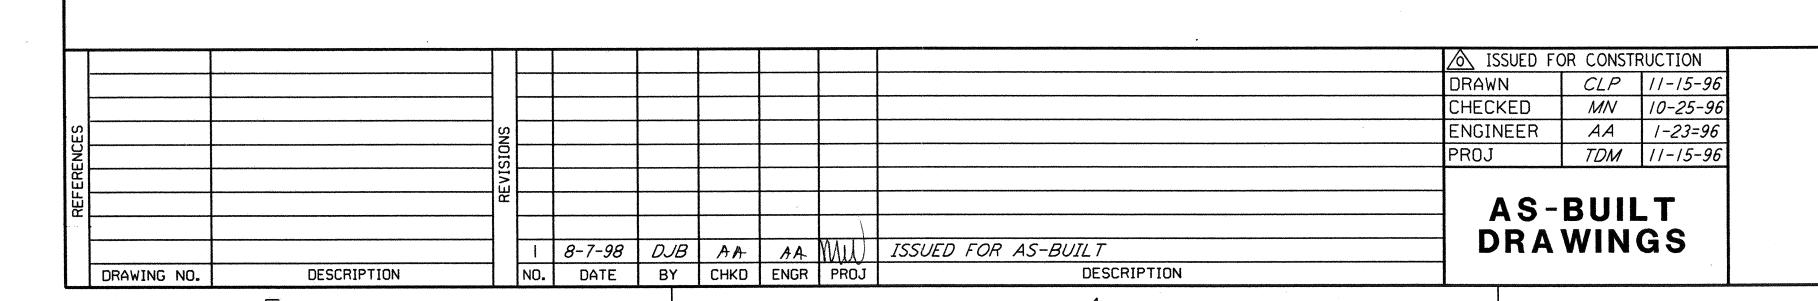



100 WEST WALNUT STREET PASADENA, CALIFORNIA

CALIFORNIA INSTITUTE OF TECHNOLOGY
MASSACHUSETTS INSTITUTE OF TECHNOLOGY

LIGO-D960989-01-O

LASER INTERFEROMETER

GRAVITATIONAL-WAVE OBSERVATORY

SITE NO. 2 - LIVINGSTON, LOUISIANA

HVAC END STATION SEQUENCES OF OPERATION & I/O SUMMARY SHEET NONE PP150969 8094

SHEET NUMBER REVISIONS

LA-H-231