not be reproduced, copied, loaned, exhibited, or used in any other way, except by written consent from PARSONS to the borrower.

This document and the design it covers are the property of PARSONS. They are loaned only with the borrower's expressed written agreement that they will

DATE: 03/21:97 TIME: 12:07:24
DESIGN FILE: I:\ligo\site2\ee\lae101.d3z

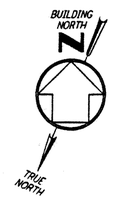

NOTES:

1. FOR GENERAL NOTES AND LEGEND, SEE DWG. LA-E-100.
2. ALL CDSAC CONDUIT EMBEDED WITHIN AND BELOW LVEA FLOOD SLABS SHALL BE 2" IN SIZE AND SPACED 4" ON CENTER AT STUB-UPS.

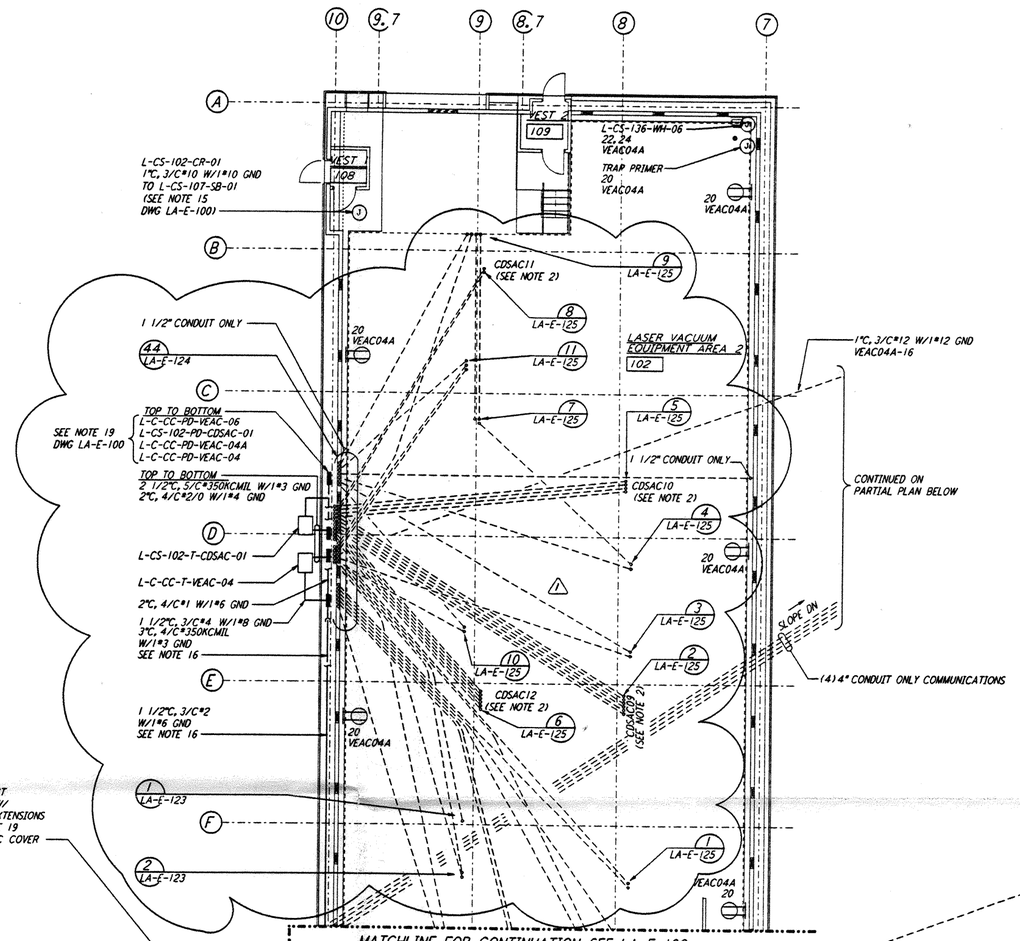

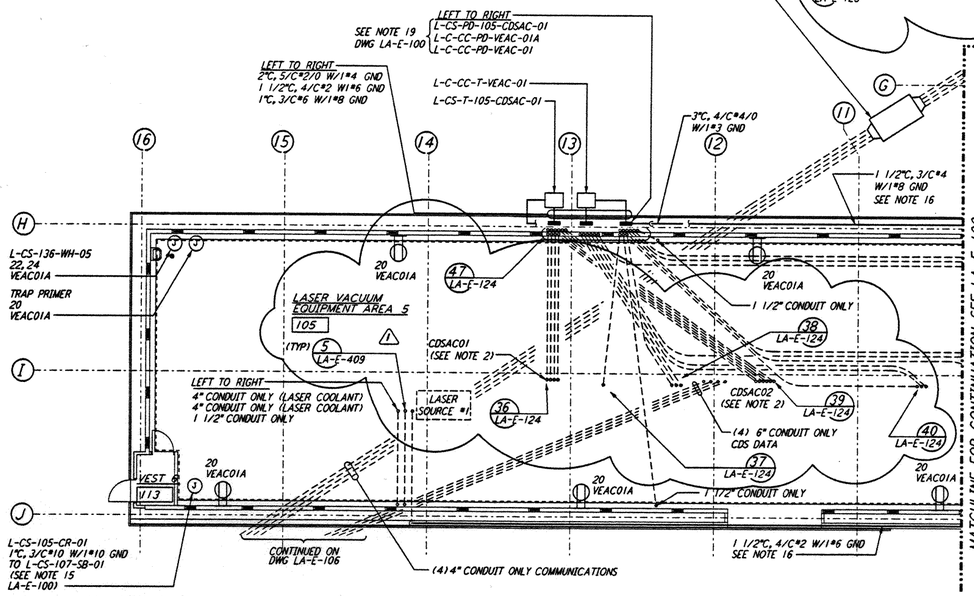

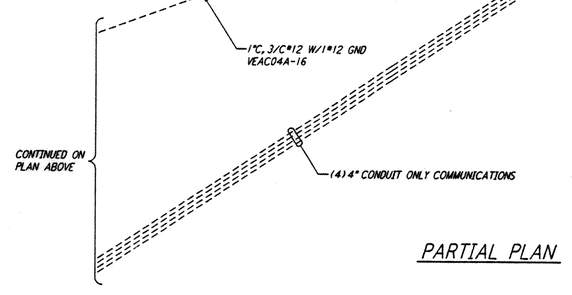

PARTIAL PLAN

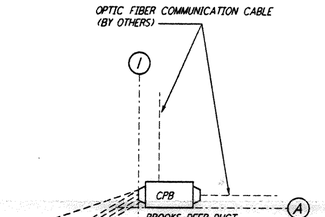

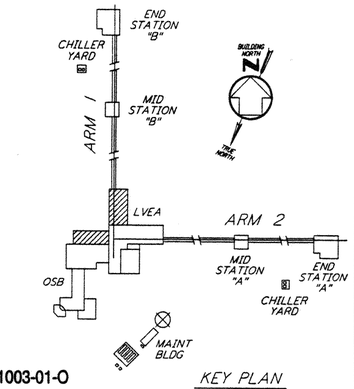

KEY PLAN

0 8 16 24 32FT
1/8" = 1'-0"

LIGO-D961003-01-O

REFERENCES		REVISIONS						
DRAWING NO.	DESCRIPTION	NO.	DATE	BY	CHKD	ENGR	PROJ	DESCRIPTION
		1	3-21-97	J.G.	[illegible]	[illegible]	[illegible]	GENERAL REVISIONS

ISSUED FOR CONSTRUCTION		
DRAWN	M. M.	11-15-96
CHECKED	J. C. L.	7-24-96
ENGINEER	K. C. R.	10-25-96
PROJ	T. O. M.	11-15-96

STATE OF LOUISIANA — REGISTERED PROFESSIONAL ENGINEER — 21 MAR 97

PARSONS
100 WEST WALNUT STREET
PASADENA, CALIFORNIA

LIGO
CALIFORNIA INSTITUTE OF TECHNOLOGY
MASSACHUSETTS INSTITUTE OF TECHNOLOGY

LASER INTERFEROMETER
GRAVITATIONAL-WAVE OBSERVATORY
SITE NO. 2 - LIVINGSTON, LOUISIANA

TITLE: ELECTRICAL
CORNER STATION
LVEA AREAS 102, 105
RECEPTACLE & POWER PLAN

SCALE	CONTRACT NUMBER	PROJECT NUMBER
NONE	PP150969	8094

SHEET NUMBER: LA-E-101
REVISIONS: 1

LIGOLAF3.BDR

Fri Mar 21 12:08:26 1997 S:\PLOTS\LAE\LAE101.PMF