not be reproduced, copied, loaned, exhibited, or used in any other way, except by written consent from **PARSONS** to the borrower.

This document and the design it covers are the property of **PARSONS**. They are loaned only with the borrower's expressed written agreement that they will

DATE: 08/12/98 TIME: 13:47:31
DESIGN FILE: I:\ligo\site2\ee\lae101.d3z

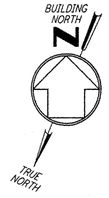

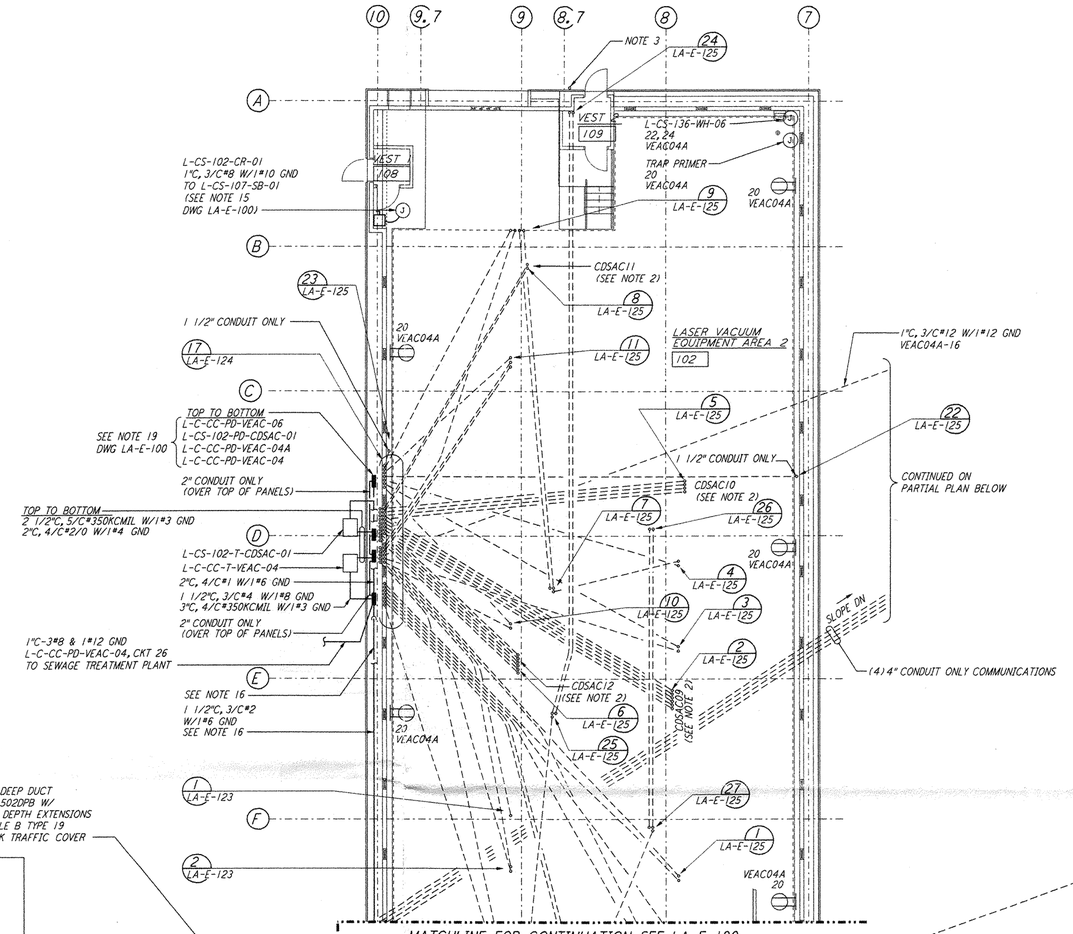

NOTES:

1. FOR GENERAL NOTES AND LEGEND, SEE DWG. LA-E-100.
2. ALL CDSAC CONDUIT EMBEDED WITHIN AND BELOW LVEA FLOOD SLABS SHALL BE 2" IN SIZE AND SPACED 4" ON CENTER AT STUB-UPS.
3. 4"C STUB-UP CONTINUE ON CIVIL DWG FOR BEAM TUBE BAKE-UP.

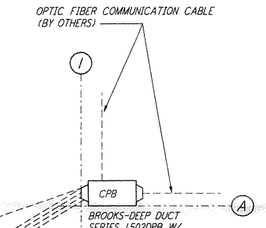

PARTIAL PLAN

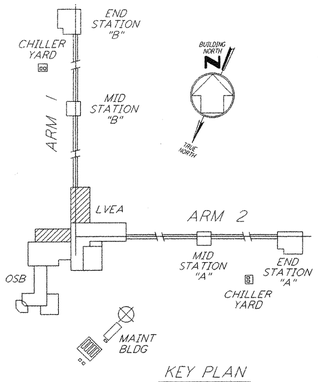

KEY PLAN

0 8 16 24 32FT
1/8" = 1'-0"

LIGO-D961003-04-O

REFERENCES		REVISIONS						
DRAWING NO.	DESCRIPTION	NO.	DATE	BY	CHKD	ENGR	PROJ	DESCRIPTION
		4	8-7-98	JE	[illegible]	[illegible]	[illegible]	ISSUED FOR AS-BUILT
		3	4-21-97	J.G.	KR	KR	TDM	REVISED FOR CDS AND VAC. EQUIP.
		2	4-4-97	M.M.	KR	KR	TDM	GENERAL REVISIONS
		1	3-21-97	J.G.	BK	KCR	TDM	GENERAL REVISIONS

ISSUED FOR CONSTRUCTION		
DRAWN	M.M.	11-15-96
CHECKED	J.C.L.	7-24-96
ENGINEER	K.C.R.	10-25-96
PROJ	T.D.M.	11-15-96

AS-BUILT DRAWINGS

PARSONS
100 WEST WALNUT STREET
PASADENA, CALIFORNIA

LIGO
CALIFORNIA INSTITUTE OF TECHNOLOGY
MASSACHUSETTS INSTITUTE OF TECHNOLOGY

LASER INTERFEROMETER
GRAVITATIONAL-WAVE OBSERVATORY
SITE NO. 2 - LIVINGSTON, LOUISIANA

TITLE: **ELECTRICAL CORNER STATION LVEA AREAS 102, 105 RECEPTACLE & POWER PLAN**

SCALE	CONTRACT NUMBER	PROJECT NUMBER
AS NOTED	PP150969	8094

SHEET NUMBER: **LA-E-101** REVISIONS: 4

LIGOLAF3.BDR

Wed Aug 12 13:46:59 1998 C:\PLOT\DWG\S2\V3682.DCF 52885 K\V3682\ee101.prf