This document and the design it covers are the property of **PARSONS**. They are loaned only with the borrower's expressed written agreement that they will not be reproduced, copied, loaned, exhibited, or used in any other way, except by written consent from **PARSONS** to The borrower.

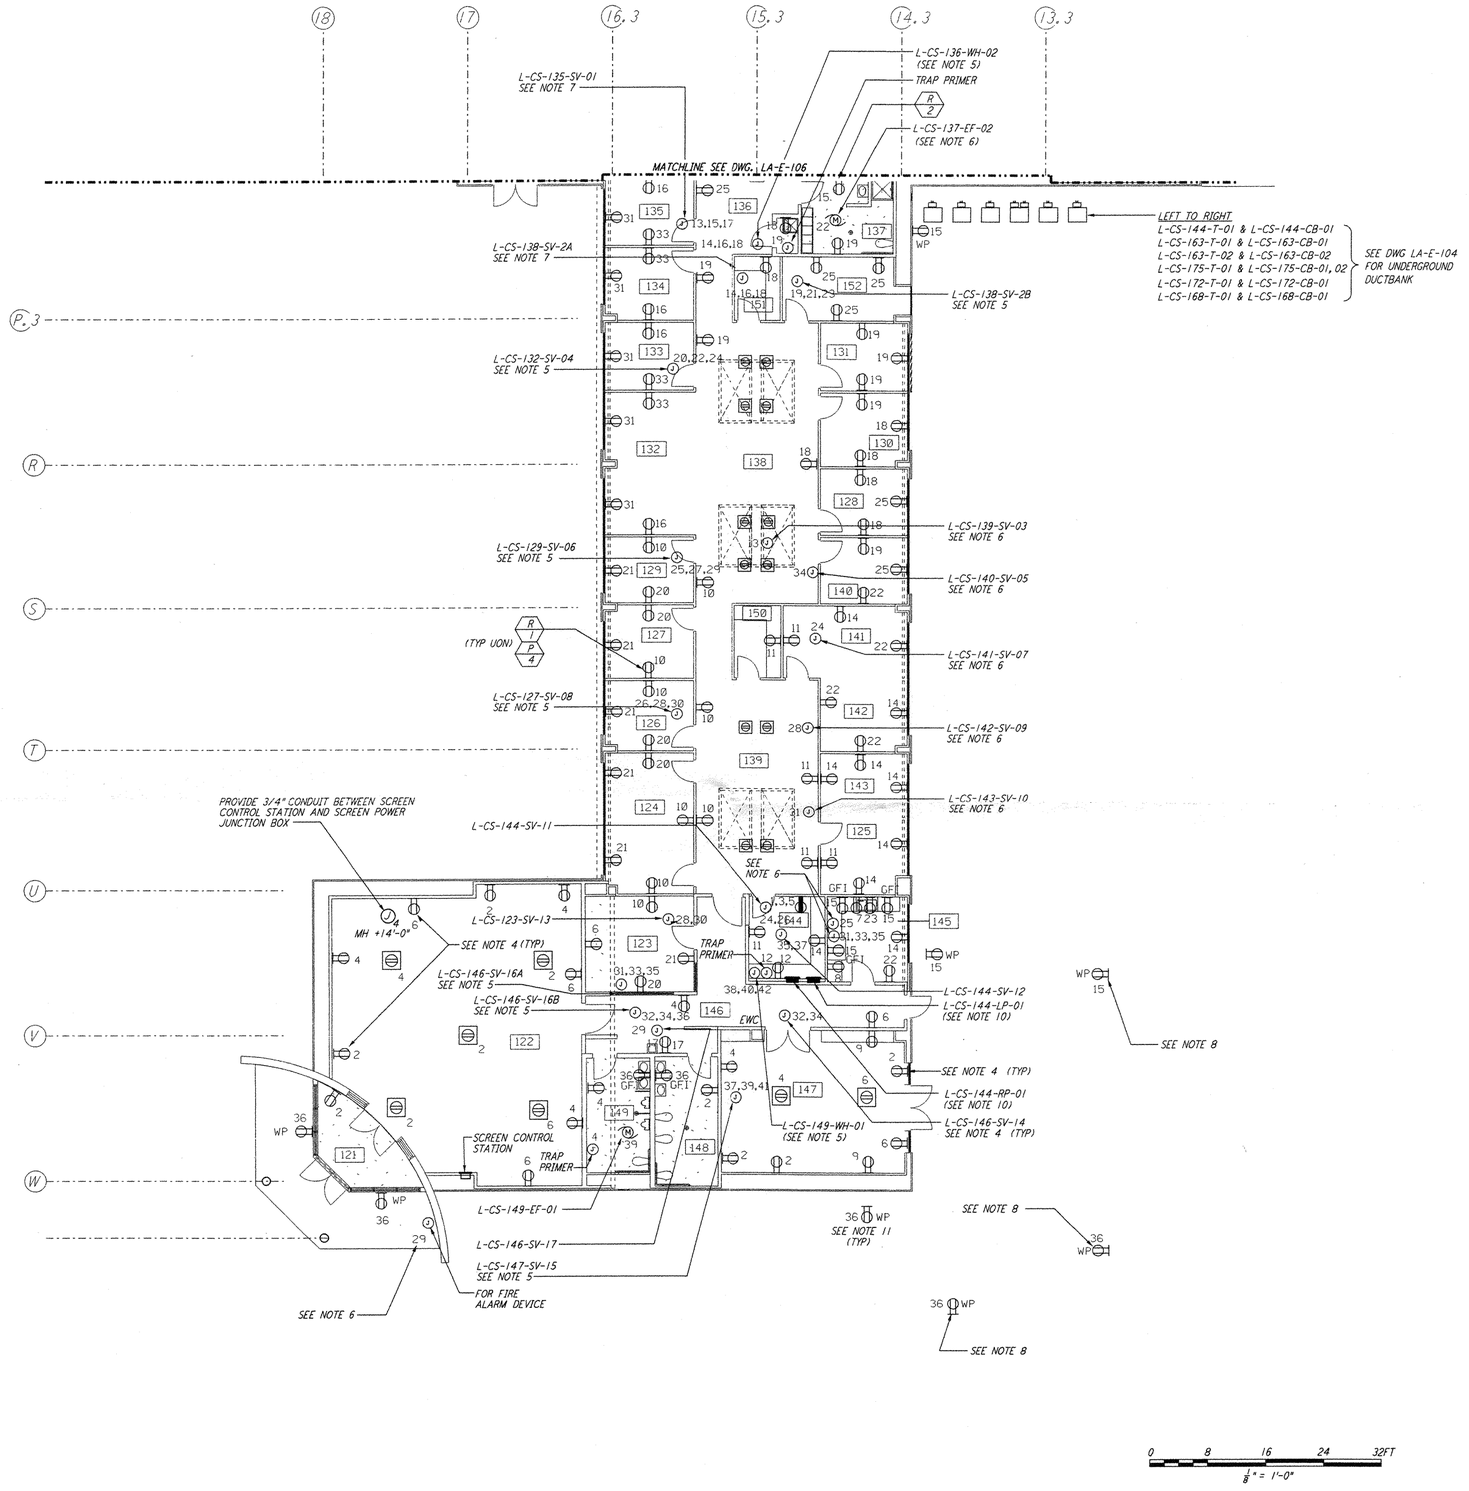

NOTES:

1. FOR ABBREVATIONS AND ACROMYMS SEE DWG LA-E-001.
2. FOR SYMBOLS SEE DWG LA-E-002.
3. FOR GENERAL NOTES, SEE DWG. LA-E-101.
4. ALL CIRCUITS SHOWN ON THIS DRAWING ARE FROM PANEL L-CS-144-RP-01 UNLESS OTHERWISE NOTED.
5. CIRCUITS SHOWN FEEDING THESE ITEMS ARE FROM PANEL L-CS-144-LP-01.
6. CIRCUITS SHOWN FEEDING THIS ITEM IS FROM PANEL L-CS-163-RP-01.
7. CIRCUITS SHOWN FEEDING THESE ITEMS ARE FROM PANEL L-CS-163-LP-01
8. CONDUIT AND WIRE FEEDING RECEPTACLES LOCATED ON PATIO WALLS SHALL ROUTE WITHIN PATIO BLOCK WALLS TO EXTERIOR WALLS OF THE OSB AS REQUIRED.
9. CONDUIT AND WIRE SHALL ROUTE WITHIN FLOOR SLAB TO WALL AS INDICATED.
10. FOR ALL PANEL FEEDER CONDUIT AND CABLE SIZES SEE SINGLE LINE DIAGRAM DWG LA-E-006. ROUTE CABLES IN CONCEALED CONDUIT TO L-CS-107-SB-01. FOR LOCATION SEE DWG LA-E-100.
11. SEE PANEL SCHEDULES ON DWG LA-E-115 & LA-E-116 FOR GFCI CIRCUITS.

REFERENCE DRAWINGS:

LA-E-115	LIGHTING AND POWER PANEL SCHEDULES
LA-E-116	LIGHTING AND POWER PANEL SCHEDULES

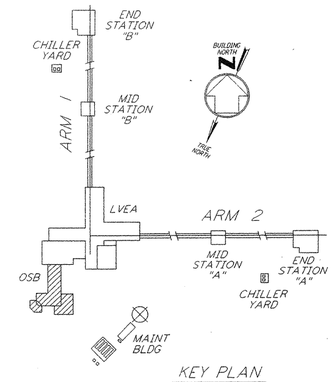

KEY PLAN

LIGO-D961007-02-O

REFERENCES		REVISIONS						
DRAWING NO.	DESCRIPTION	NO.	DATE	BY	CHKD	ENGR	PROJ	DESCRIPTION
		2	8-7-98	JE	O.K.	KCR	T.D.M	ISSUED FOR AS-BUILT
		1	2-28-97	J.G.	RDC	KCR	T.D.M	GENERAL REVISIONS

ISSUED FOR CONSTRUCTION		
DRAWN	M.M.	11-15-96
CHECKED	J.C.L.	7-24-96
ENGINEER	K.C.R.	10-25-96
PROJ	T.D.M.	11-15-96

AS-BUILT DRAWINGS

PARSONS
100 WEST WALNUT STREET
PASADENA, CALIFORNIA

LIGO
CALIFORNIA INSTITUTE OF TECHNOLOGY
MASSACHUSETTS INSTITUTE OF TECHNOLOGY

LASER INTERFEROMETER GRAVITATIONAL-WAVE OBSERVATORY
SITE NO. 2 - LIVINGSTON, LOUISIANA

TITLE
ELECTRICAL CORNER STATION OSB OFFICE AREA RECEPTACLE & POWER PLAN

SCALE	CONTRACT NUMBER	PROJECT NUMBER
NONE	PP150969	8094

SHEET NUMBER **LA-E-105** REVISIONS 2

LIGOLAF3.BDR

Mon Aug 17 13:30:06 1998 G:\PLOTJOBS\S3-V3682.DGF 52895 K:\V3682\ee\lae105.prf