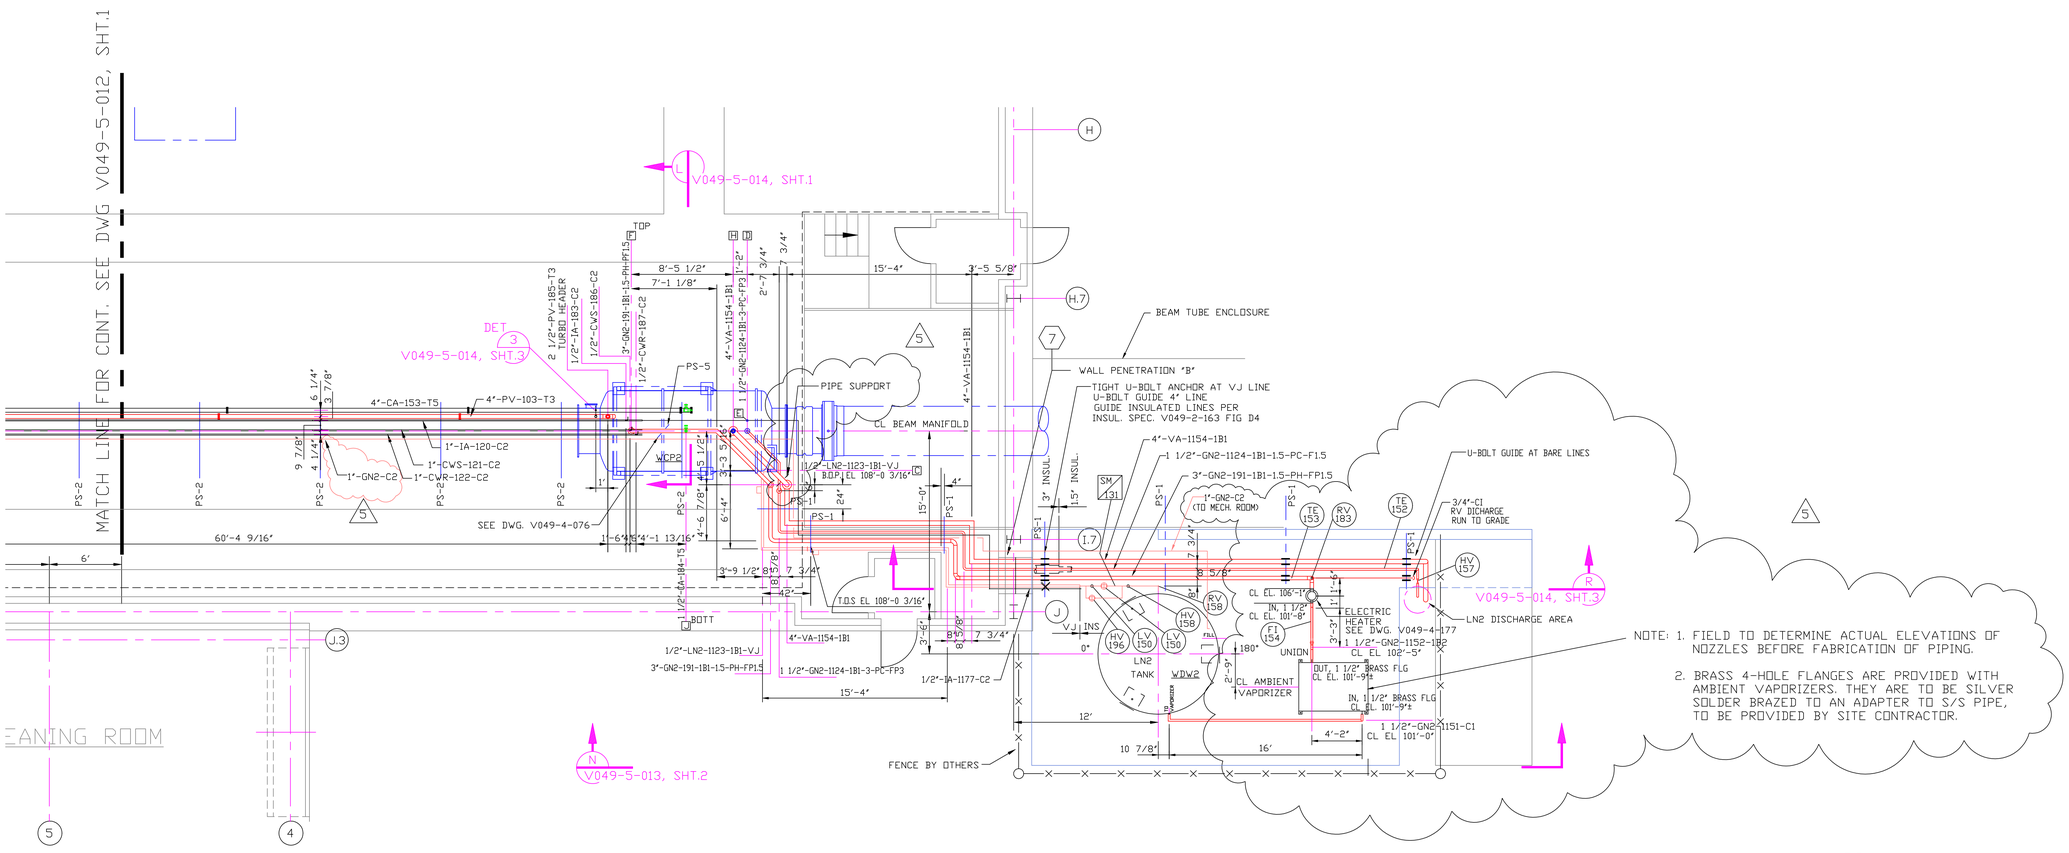

NOTE: 1. FIELD TO DETERMINE ACTUAL ELEVATIONS OF NOZZLES BEFORE FABRICATION OF PIPING.

2. BRASS 4-HOLE FLANGES ARE PROVIDED WITH AMBIENT VAPORIZERS. THEY ARE TO BE SILVER SOLDER BRAZED TO AN ADAPTER TO S/S PIPE, TO BE PROVIDED BY SITE CONTRACTOR.

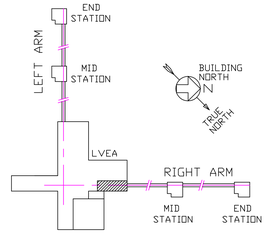

PROCESS SYSTEMS INTERNATIONAL INC.
20 WALKUP DR. WESTBOROUGH, MASSACHUSETTS 01581 USA

PIPING ARRANGEMENT
PLAN
CORNER STATION WASHINGTON
LIGO VACUUM EQUIPMENT

CAD FILE	SIZE	DWG. NO.	REV.
V0495012/5012S3	D	V049-5-012	5
SCALE 3/16"=1'-0"		SHEET 3 OF 4	

Jun 18, 1998 - 12:23:15

EDUCATION VERSION - NOT FOR COMMERCIAL USE