DATE: 09/29:98 TIME: 12:01:49
DESIGN FILE: I:\ligo\site2\st\las502.dgz

PARSONS is to be borrower's expressed written agreement that they will

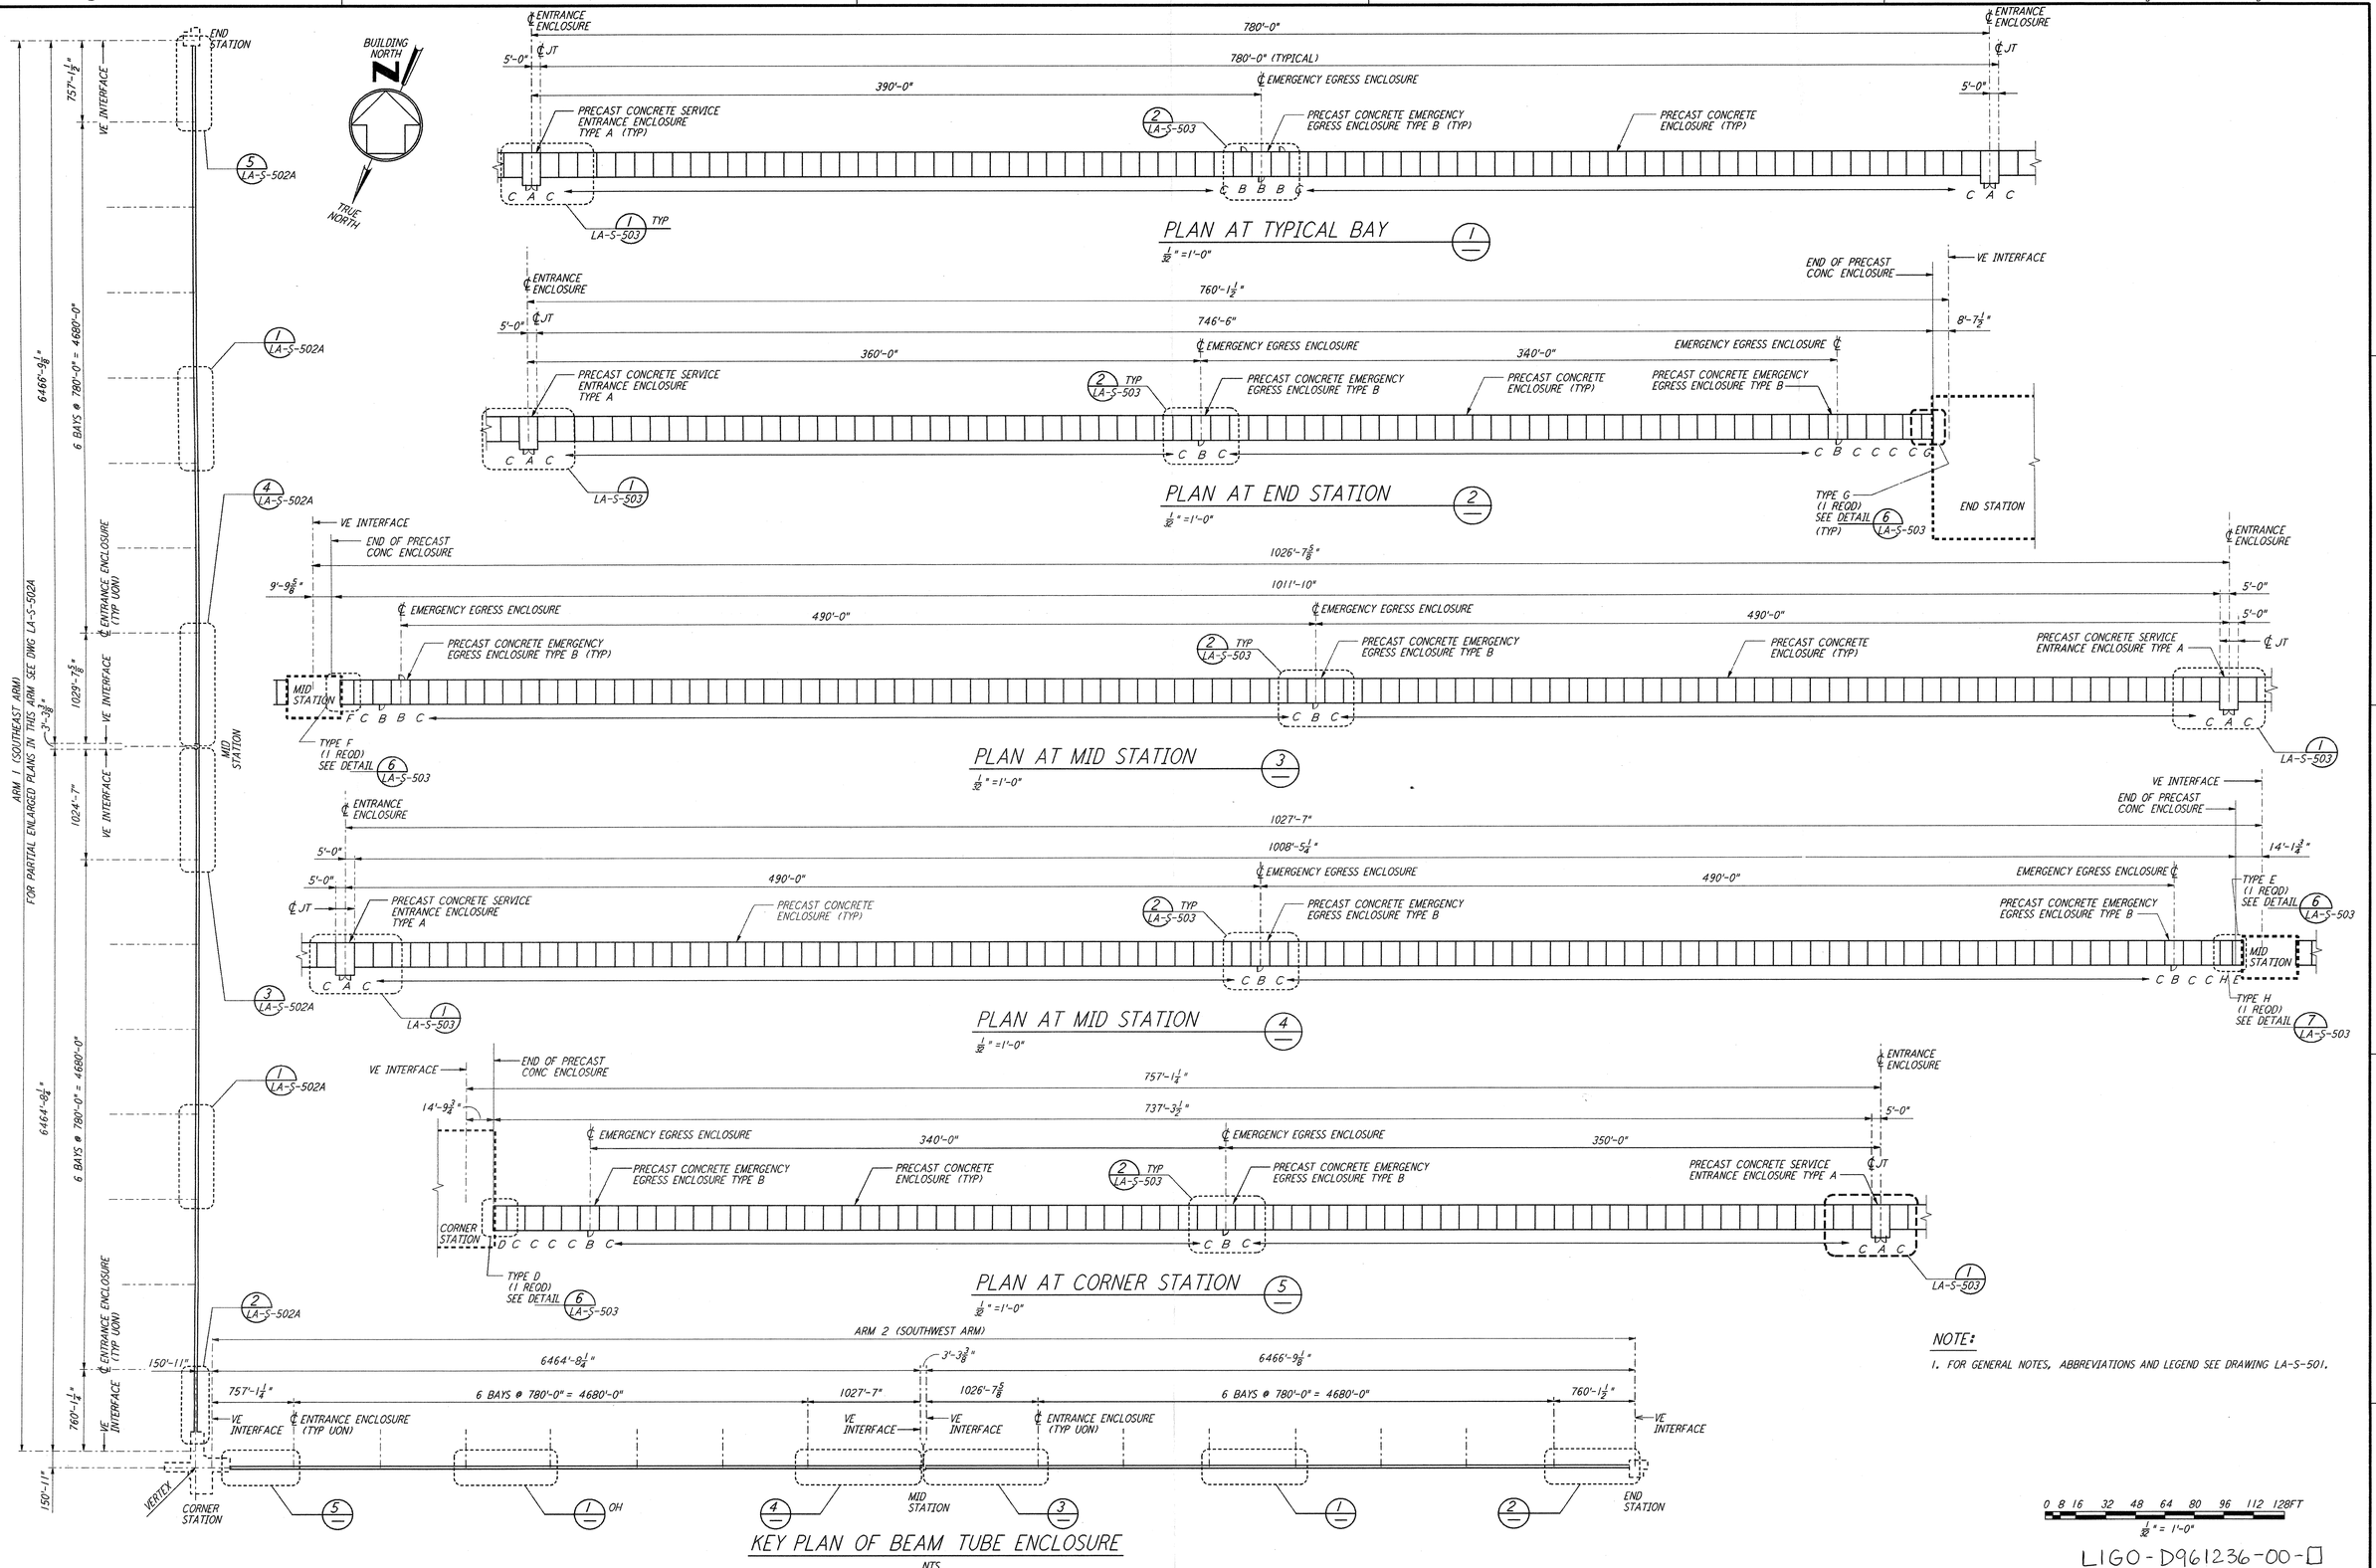

NOTE:

1. FOR GENERAL NOTES, ABBREVIATIONS AND LEGEND SEE DRAWING LA-S-501.

LIGO-D961236-00-D

REFERENCES			REVISIONS						
DRAWING NO.	DESCRIPTION		NO.	DATE	BY	CHKD	ENGR	PROJ	DESCRIPTION
			2	9-25-98	JD	[illegible]	[illegible]	[illegible]	ISSUED FOR AS BUILT
			1	2-28-97	GP	TDM	GP	TDM	REV DIMENSIONS & ENCLOSURE TYPES

ISSUED FOR CONSTRUCTION		
DRAWN	MCS	11-15-96
CHECKED	DDM	11-15-96
ENGINEER	BP	11-15-96
PROJ	TDM	11-15-96

PARSONS
100 WEST WALNUT STREET
PASADENA, CALIFORNIA

LIGO
CALIFORNIA INSTITUTE OF TECHNOLOGY
MASSACHUSETTS INSTITUTE OF TECHNOLOGY

LASER INTERFEROMETER GRAVITATIONAL-WAVE OBSERVATORY
BEAM TUBE ENCLOSURE - LIVINGSTON, LA

TITLE: STRUCTURAL KEY PLAN OF BEAM TUBE ENCLOSURE & PARTIAL ENLARGED PLANS

SCALE	CONTRACT NUMBER	PROJECT NUMBER
AS NOTED	PP150969	8094

SHEET NUMBER: LA-S-502 REVISIONS: 2

Sep 29 12:00:27 1998 PRINTED AT LIVINGSTON