



- NOTES:**
- SEE SHEET LA-C-502 FOR GENERAL NOTES, LEGEND AND ABBREVIATIONS.
 - SEE SHEET LA-C-504 FOR TYPICAL SECTIONS AND DETAILS.


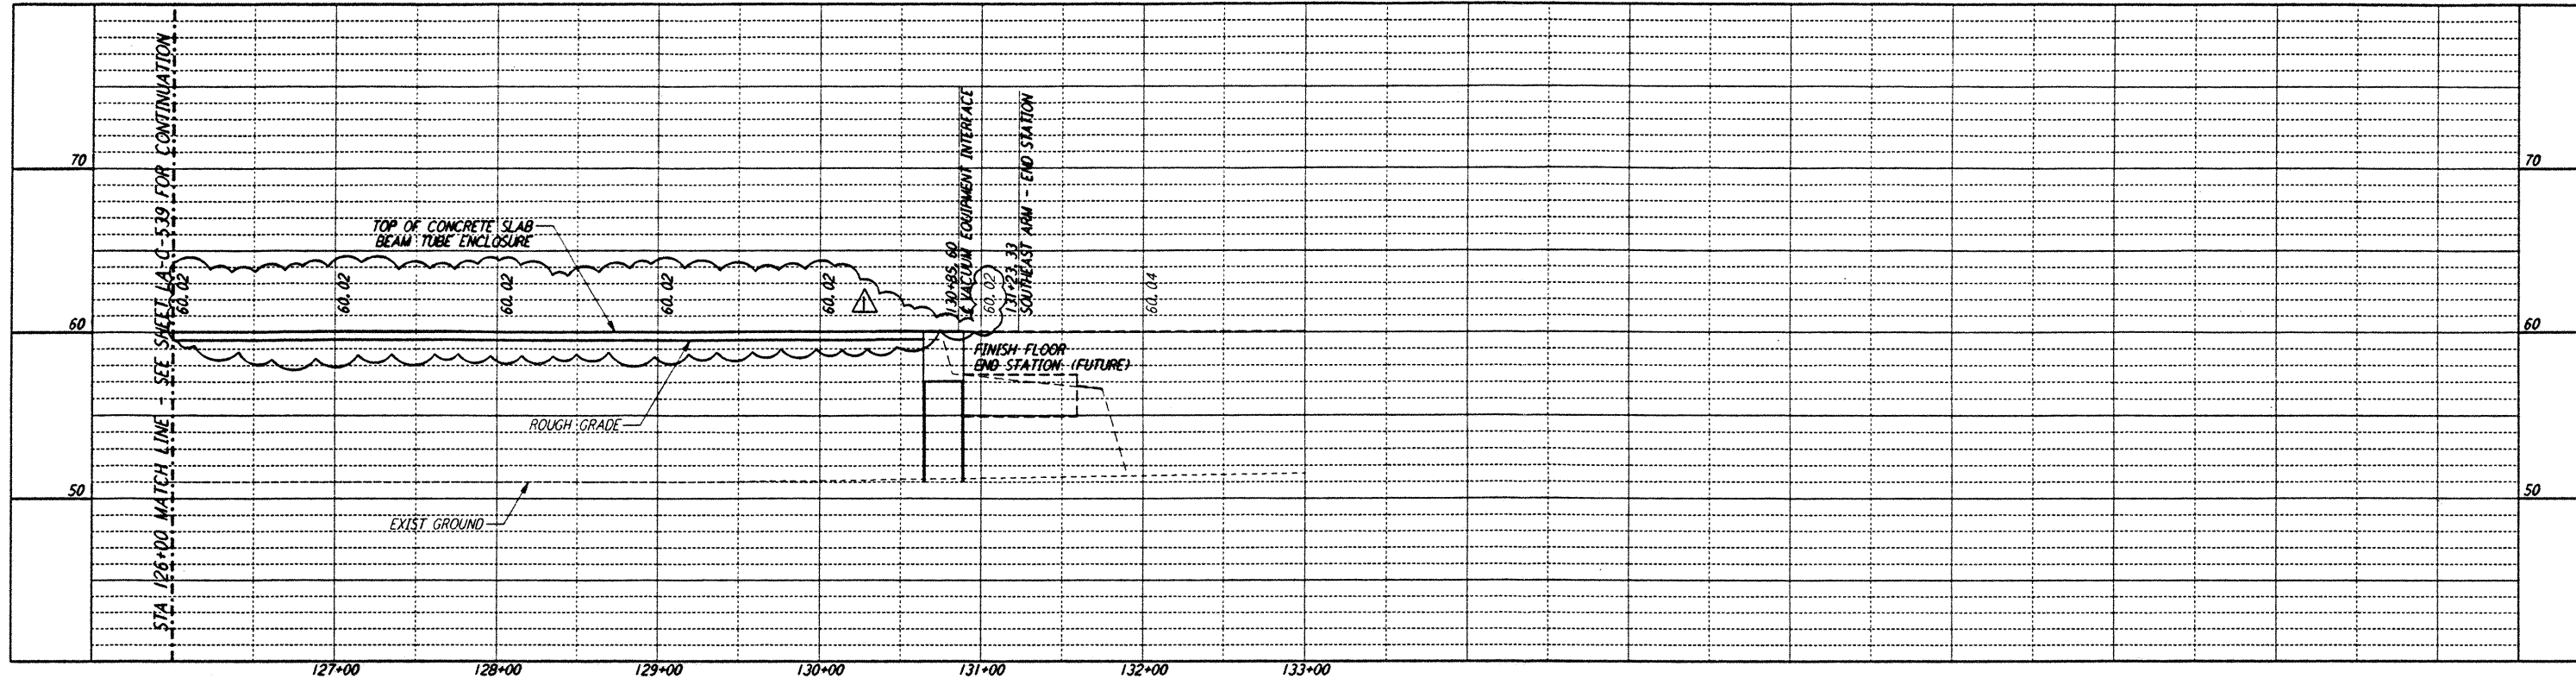


| CURVE DATA | | | | | |
|------------|-----------|--------|---------|--------|--------|
| Δ | RADIUS | LENGTH | TANGENT | REMARK | |
| 1 | 35°00'00" | 110' | 67.19' | 34.68' | ↑ ROAD |
| 2 | 35°00'00" | 100' | 61.07' | 31.53' | ↑ ROAD |


PROFILE
 SCALES: HORIZ: 1" = 50'
 VERT: 1" = 5'

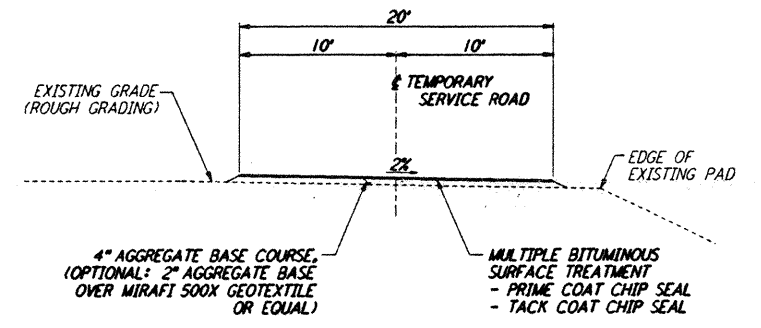

TEMPORARY SERVICE ROAD
 NOT TO SCALE

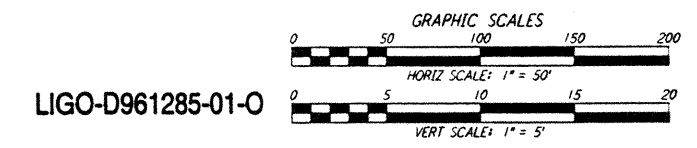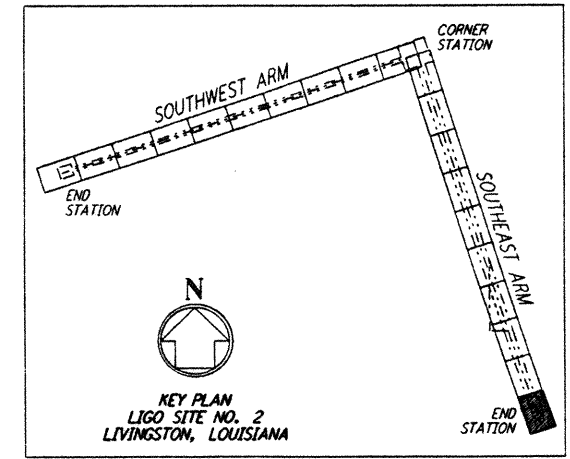

LIGO-D961285-01-0

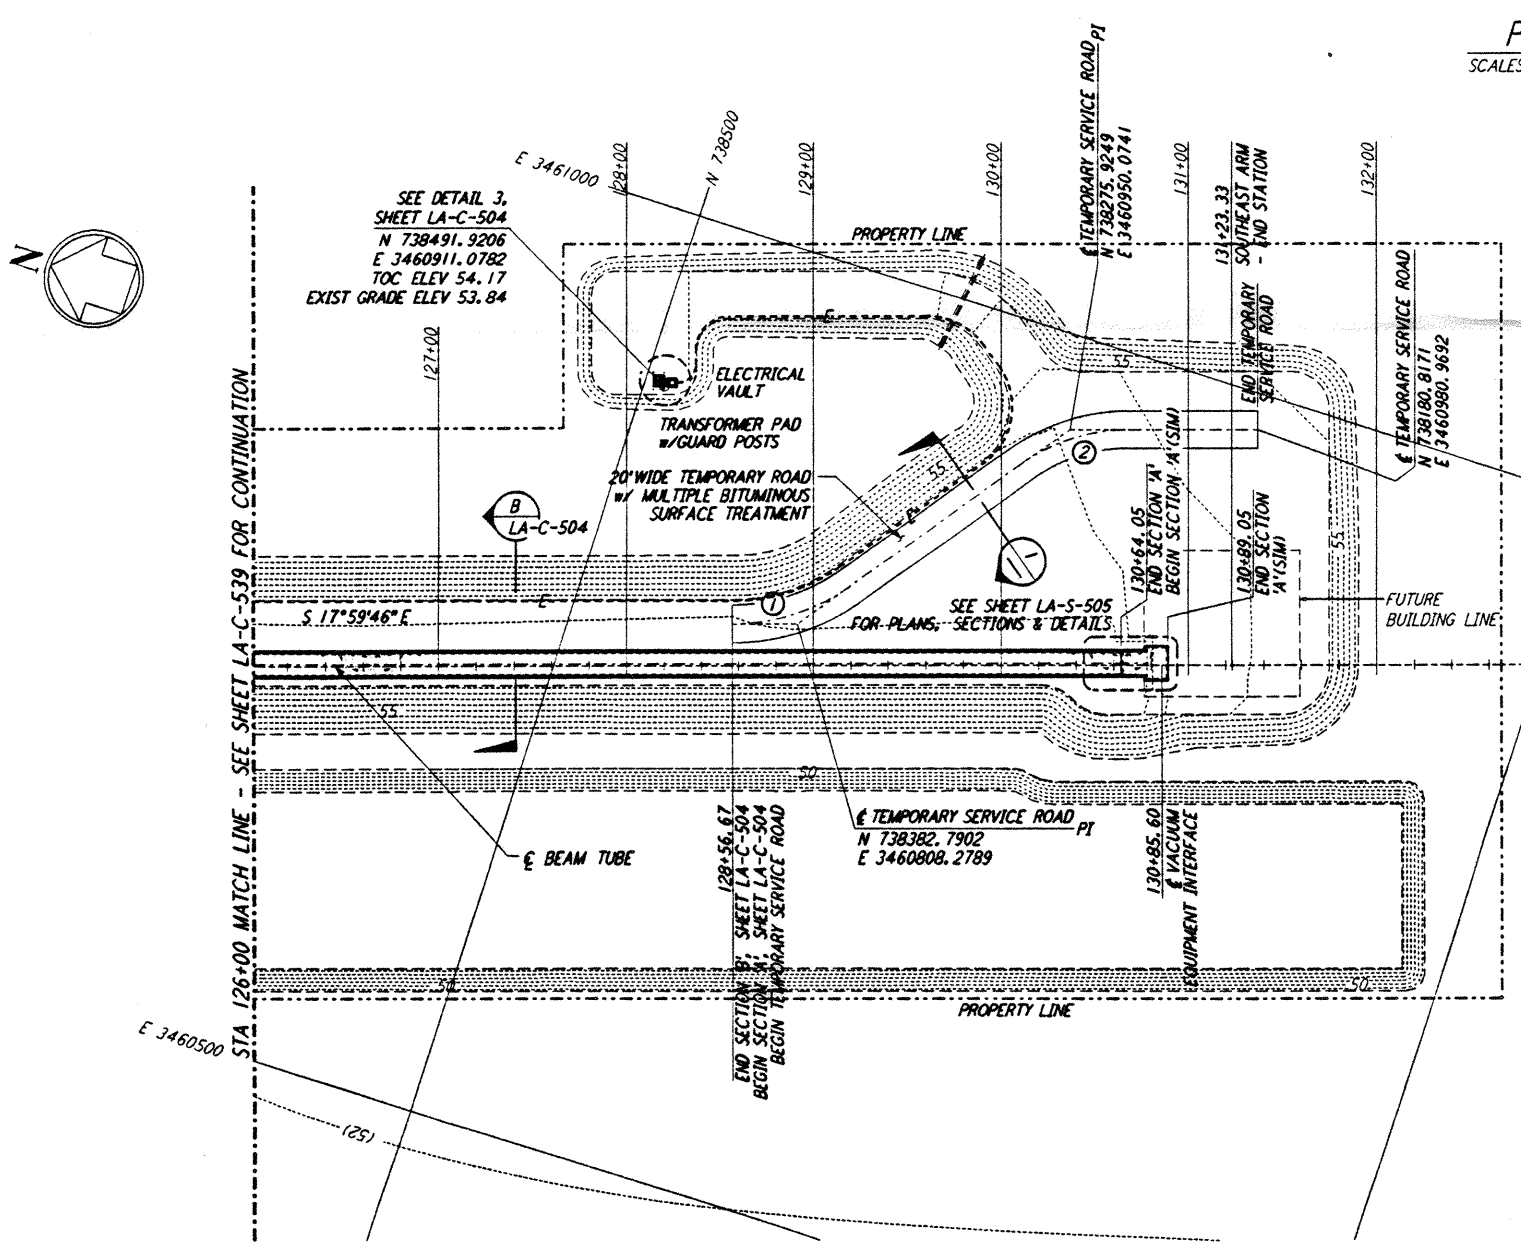


PLAN
 SCALE: 1" = 50'

This document and the design it covers are the property of PARSONS. They are loaned only with the borrower's expressed written agreement that they will not be reproduced, copied, loaned, exhibited, or used in any other way, except by written consent from PARSONS to the borrower.

| NO. | DATE | BY | CHKD | ENGR | PROJ | REVISIONS |
|-----|--------|-----|------|------|------|----------------------------|
| 1 | 2-3-97 | WRB | CI | JB | TDM | REVISED PROFILE ELEVATIONS |

| ISSUED FOR CONSTRUCTION | |
|-------------------------|--------------|
| DRAWN | WRB 11-15-96 |
| CHECKED | ML 11-15-96 |
| ENGINEER | JB 11-15-96 |
| PROJ | TDM 11-15-96 |

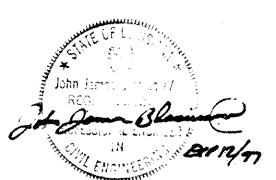

PARSONS
 100 WEST WALNUT STREET
 PASADENA, CALIFORNIA

LIGO
 CALIFORNIA INSTITUTE OF TECHNOLOGY
 MASSACHUSETTS INSTITUTE OF TECHNOLOGY

**LASER INTERFEROMETER
 GRAVITATIONAL-WAVE OBSERVATORY
 BEAM TUBE ENCLOSURE - LIVINGSTON, LA**

TITLE: CIVIL SOUTHEAST ARM PLAN AND PROFILE STA 126+00 TO STA 133+00
 SCALE: AS NOTED
 CONTRACT NUMBER: PPI 50969
 PROJECT NUMBER: 8094
LA-C-540

LIGO-D961285-01-0

LIG00LTF3.80R