



This document and the design it covers are the property of PARSONS. They are loaned only with the borrower's expressed written agreement that they will not be reproduced, copied, loaned, exhibited, or used in any other way, except by written consent from PARSONS to the borrower.

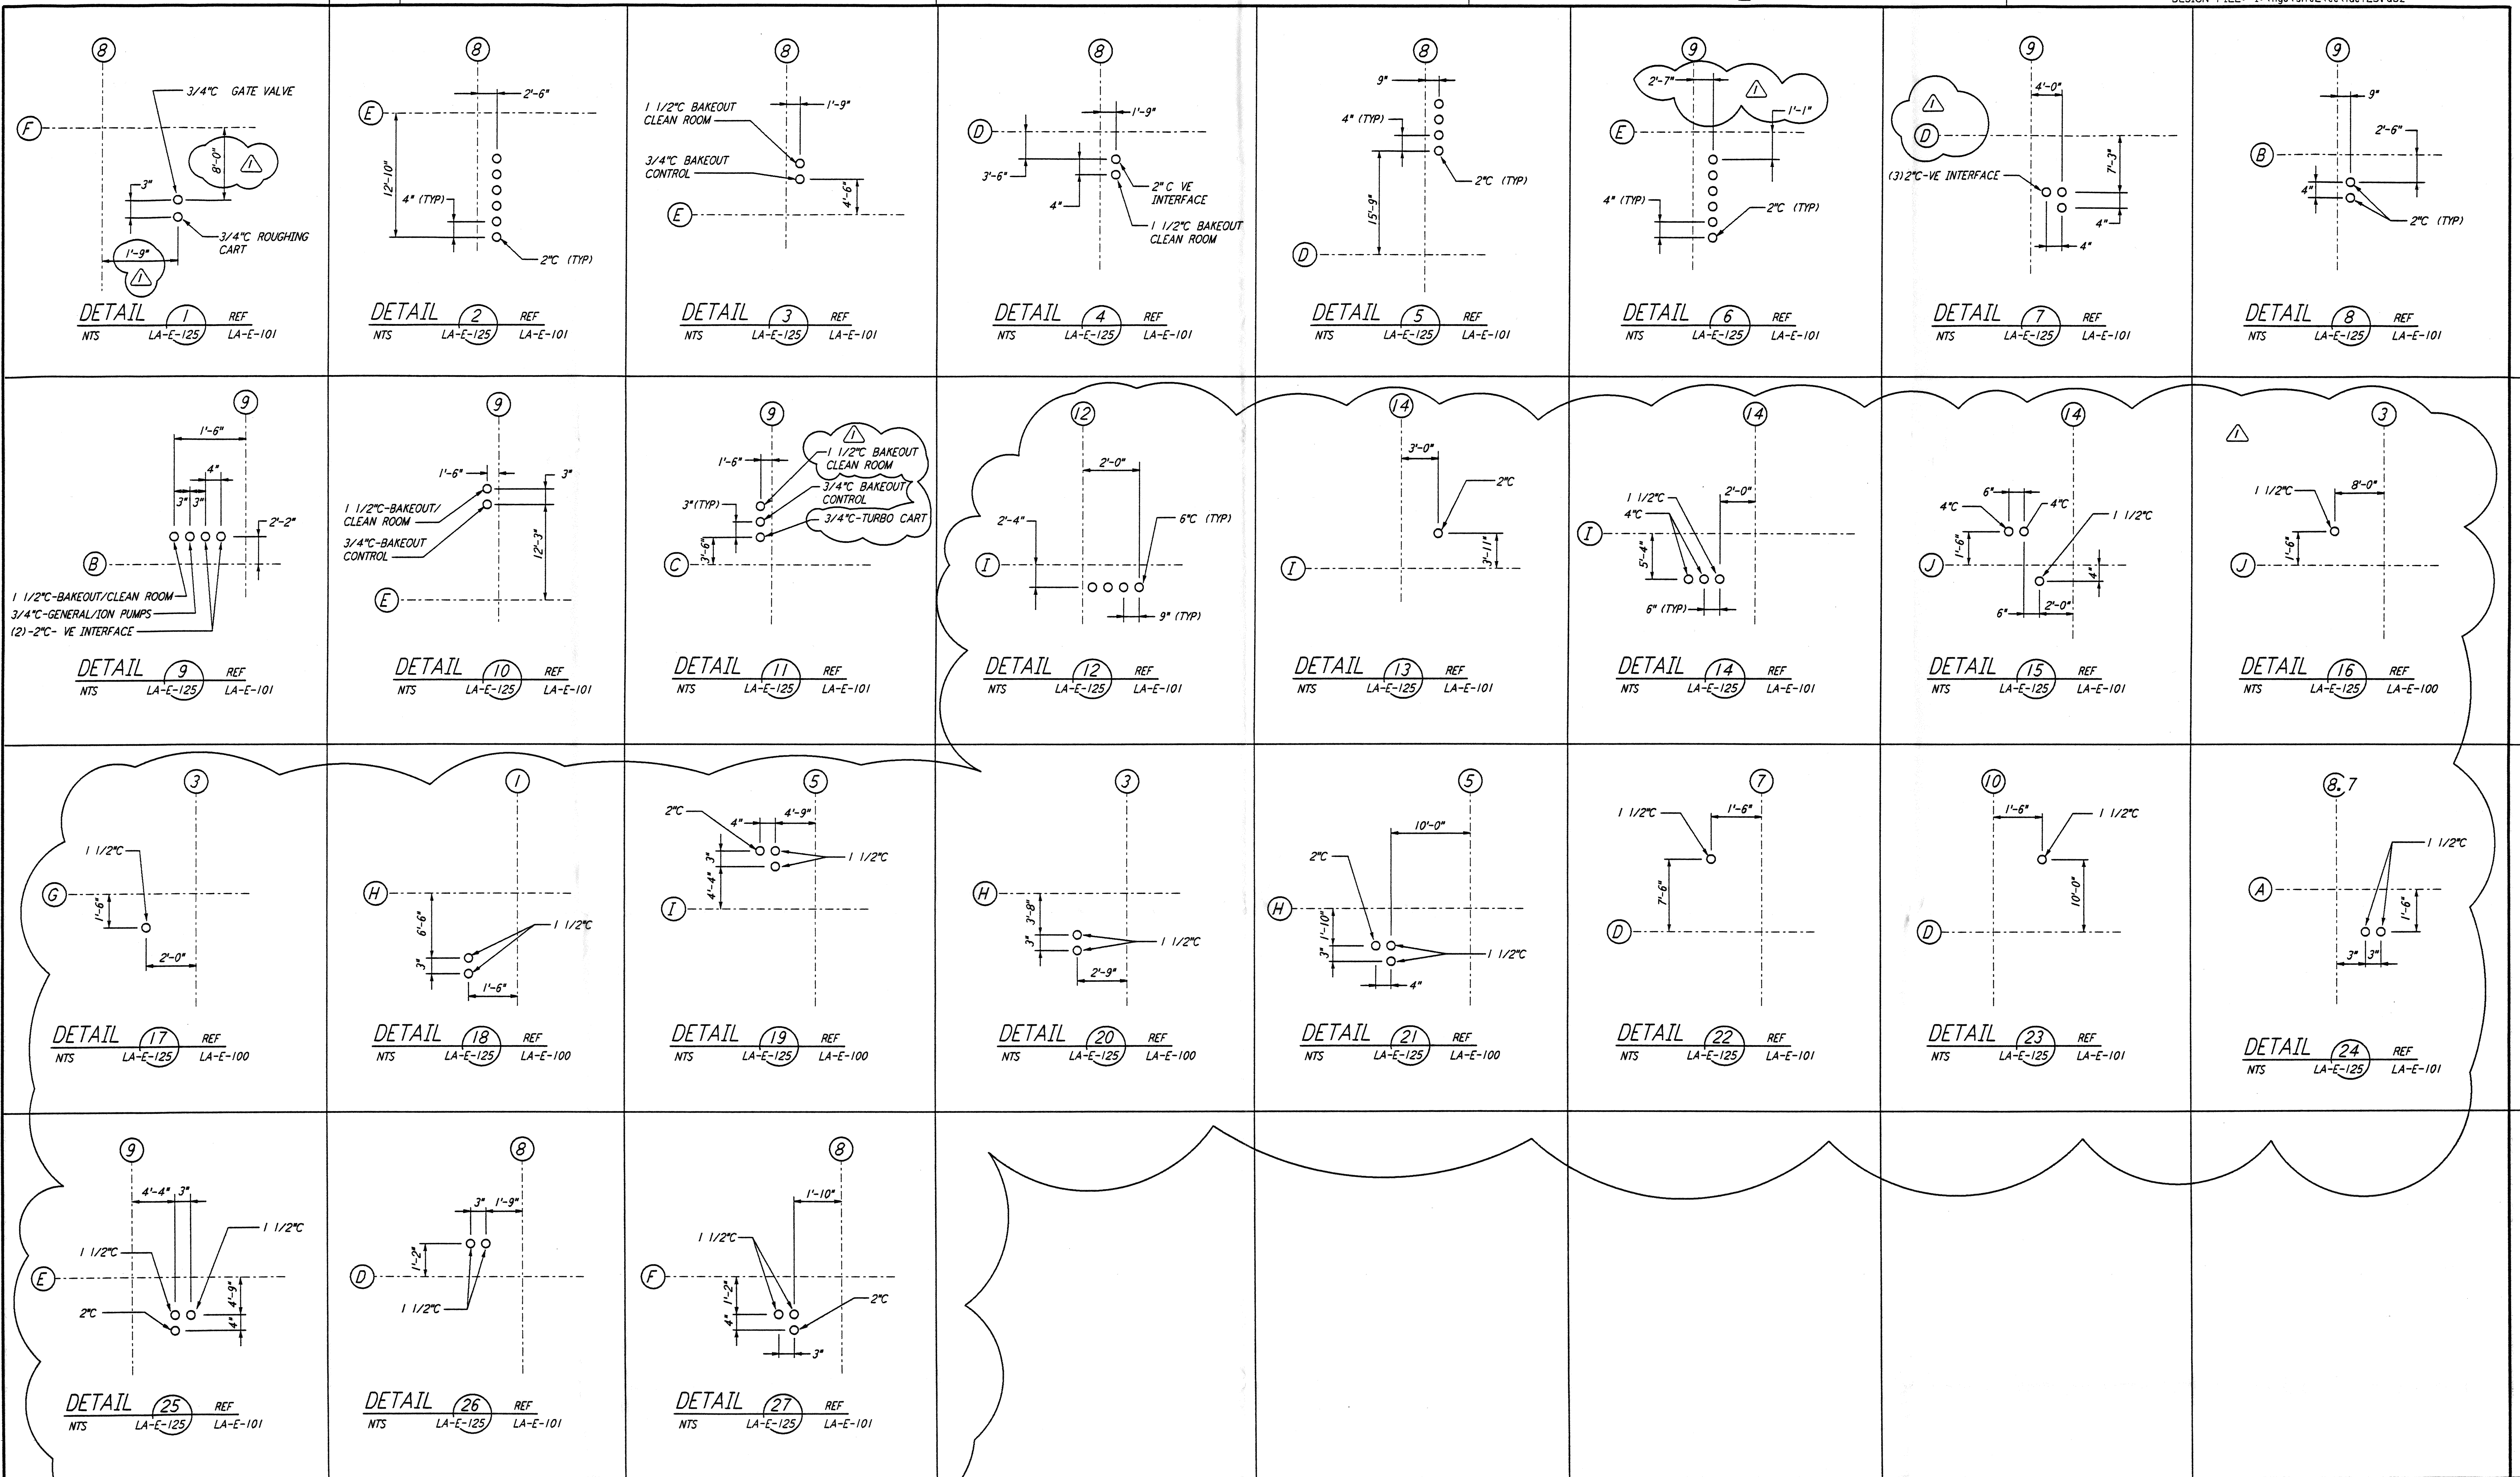

NOTE: THE DETAILS ON SHEETS LA-E-123, LA-E-124 AND LA-E-125 SUPERSEDE, ENTIRELY THE DETAILS ON SHEET LA-E-114

NO.	DATE	BY	CHKD	ENGR	PROJ	DESCRIPTION
1	4-4-97	J. G.				GENERAL REVISIONS

ISSUED FOR CONSTRUCTION  
 DRAWN J. G. 3-21-97  
 CHECKED B. K. 3-21-97  
 ENGINEER K. C. R. 3-21-97  
 PROJ T. D. M. 3-21-97

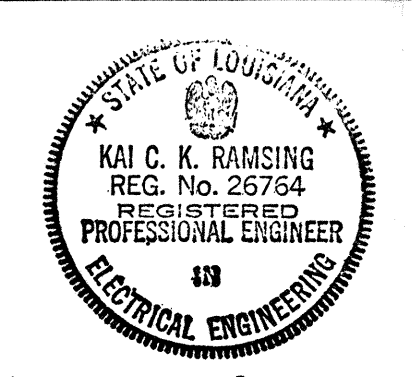

LIGO-D961481-01-0

LASER INTERFEROMETER  
 GRAVITATIONAL-WAVE OBSERVATORY  
 SITE NO. 2 - LIVINGSTON, LOUISIANA

TITLE	SCALE	CONTRACT NUMBER	PROJECT NUMBER
ELECTRICAL CORNER STATION LVEA AREAS 101, 102, 103, 104 DETAILS	NONE	PPI50969	8094
SHEET NUMBER		REVISIONS	
LA-E-125			