



not be reproduced, copied, loaned, exhibited, or used in any other way, except by written consent from PARSONS to the borrower.


This document and the design it covers are the property of PARSONS. They are loaned only with the borrower's expressed written agreement that they will not be reproduced, copied, loaned, exhibited, or used in any other way, except by written consent from PARSONS to the borrower.

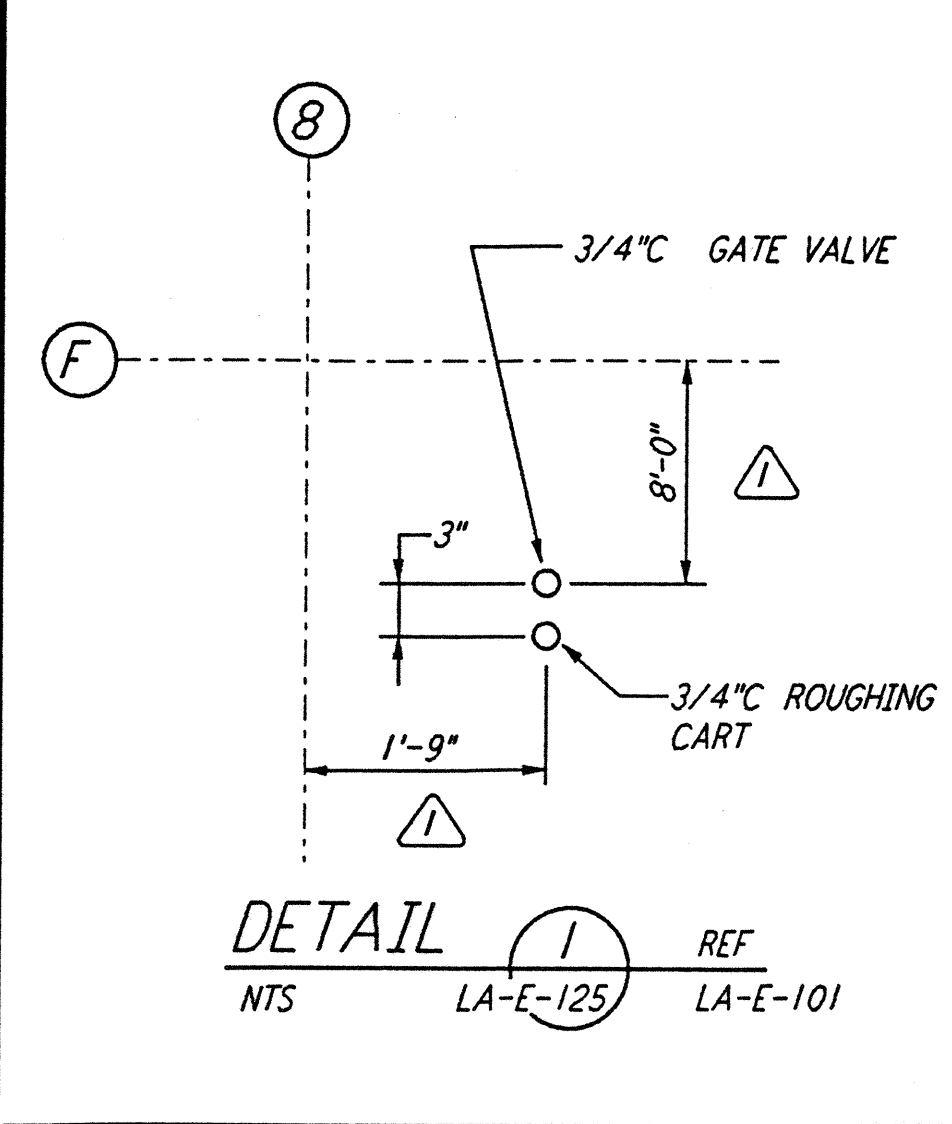


DETAIL 1 REF
 NTS LA-E-125 LA-E-101

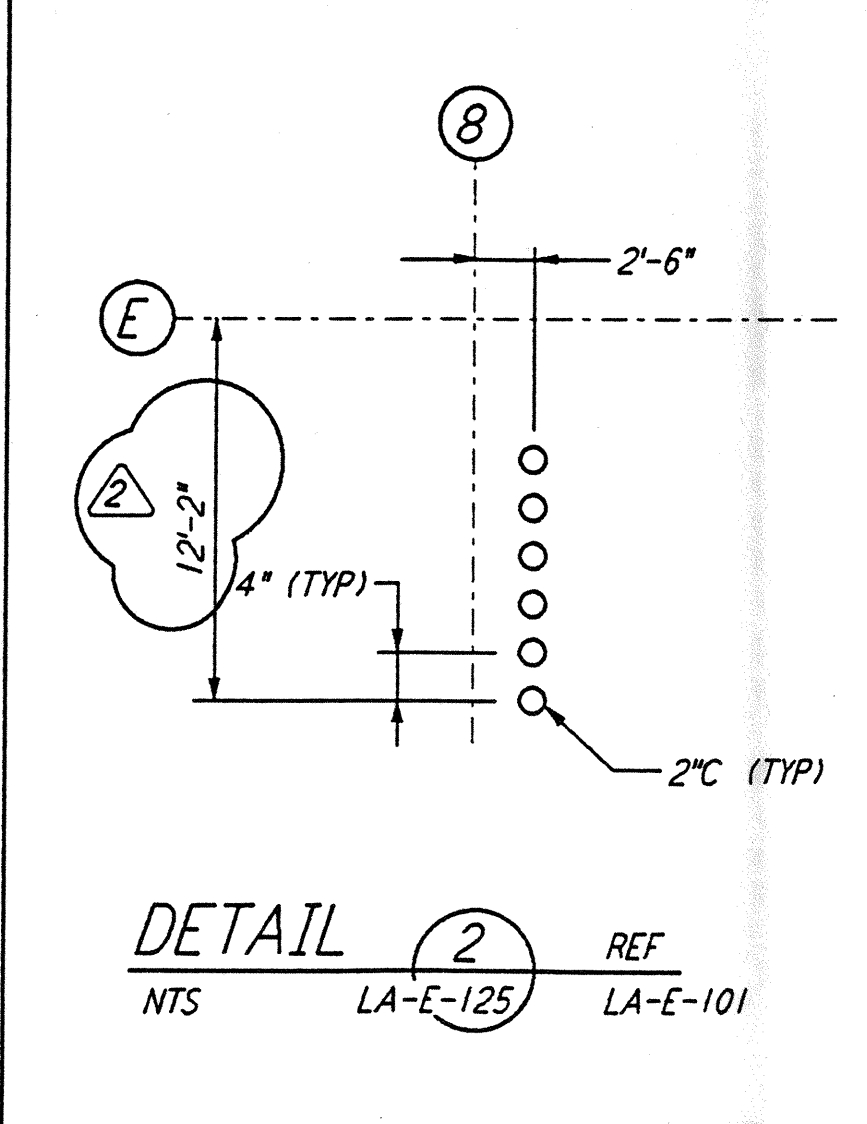


DETAIL 2 REF
 NTS LA-E-125 LA-E-101

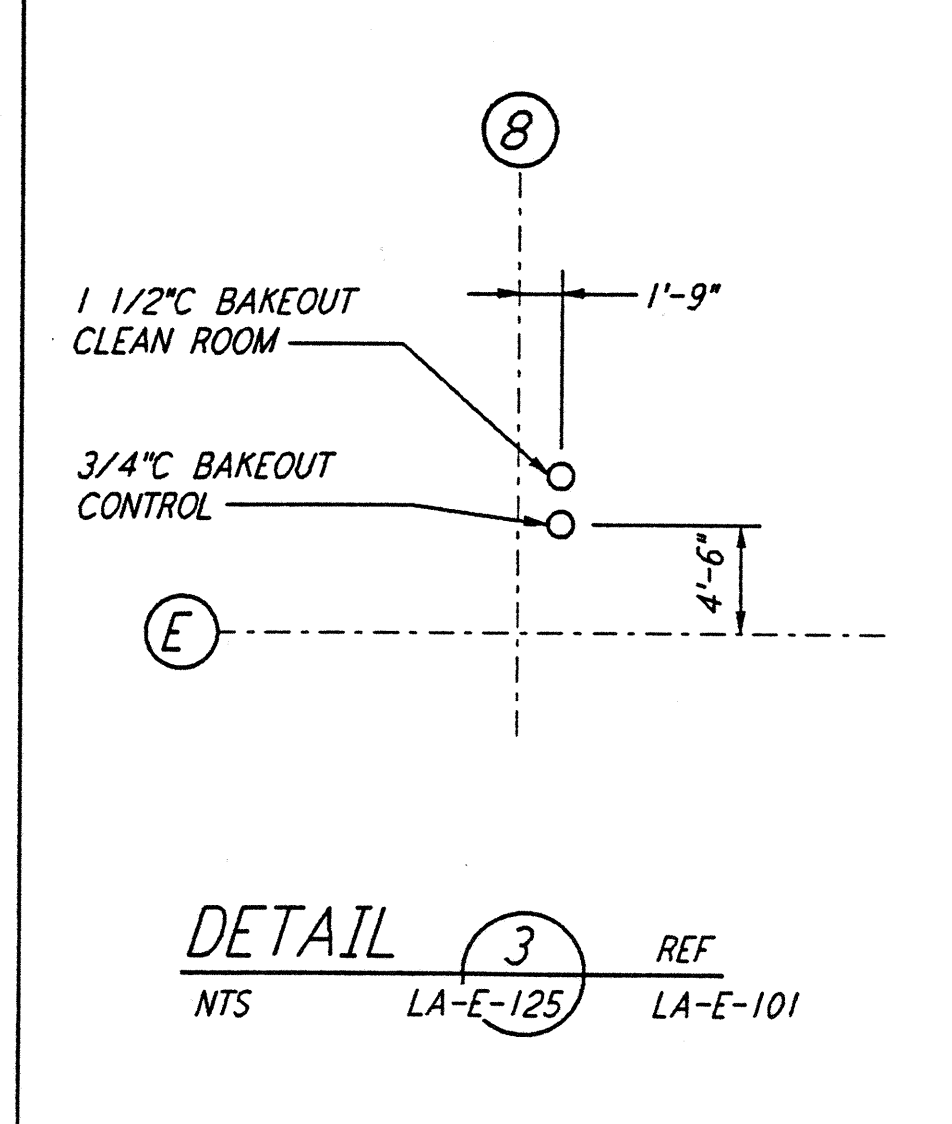


DETAIL 3 REF
 NTS LA-E-125 LA-E-101

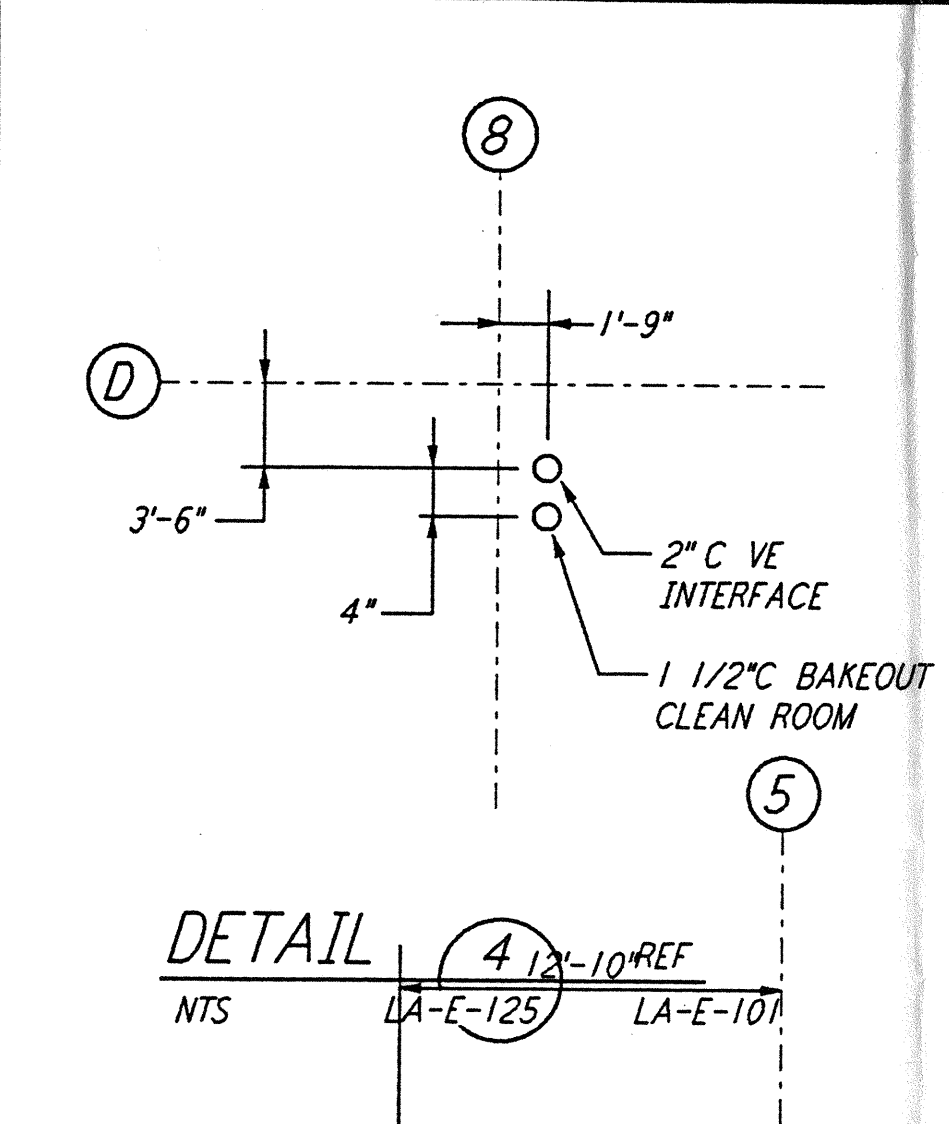


DETAIL 4 REF
 NTS LA-E-125 LA-E-101

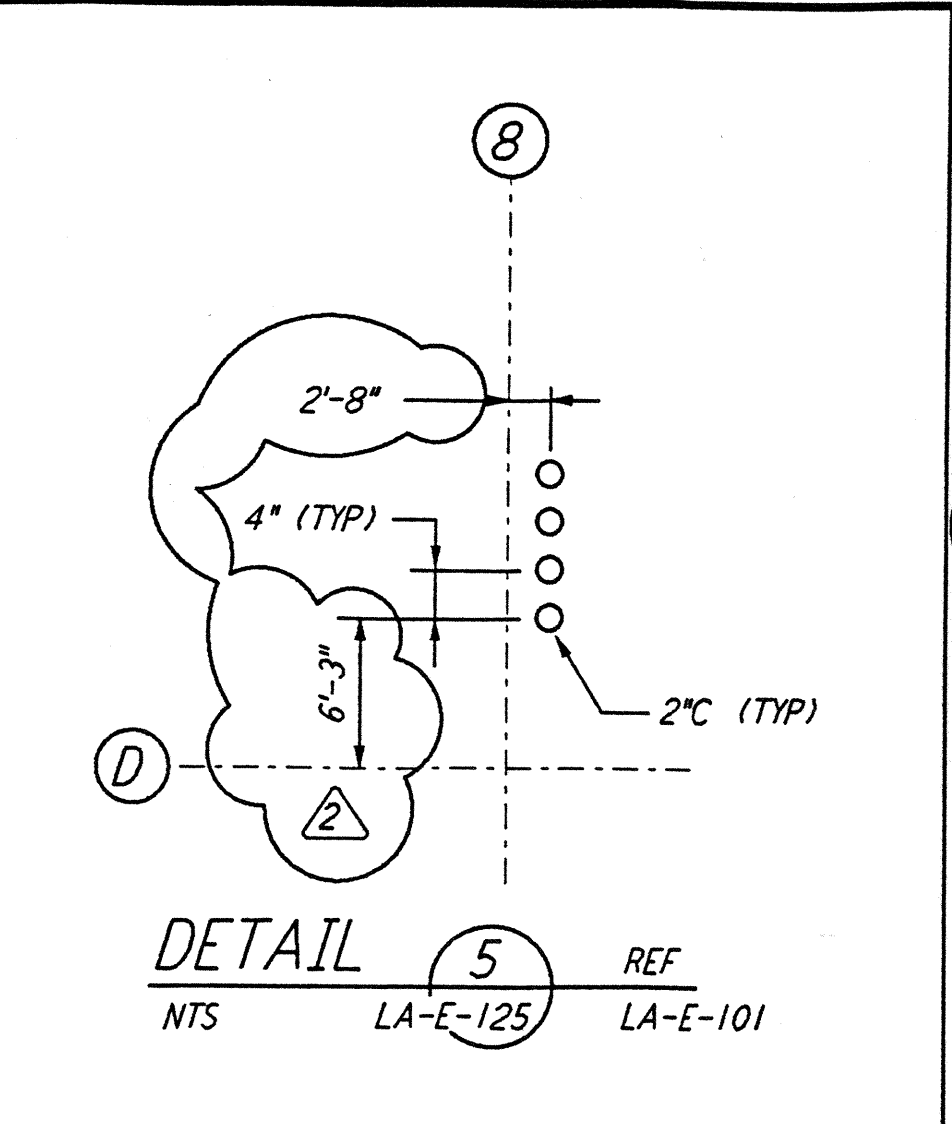


DETAIL 5 REF
 NTS LA-E-125 LA-E-101

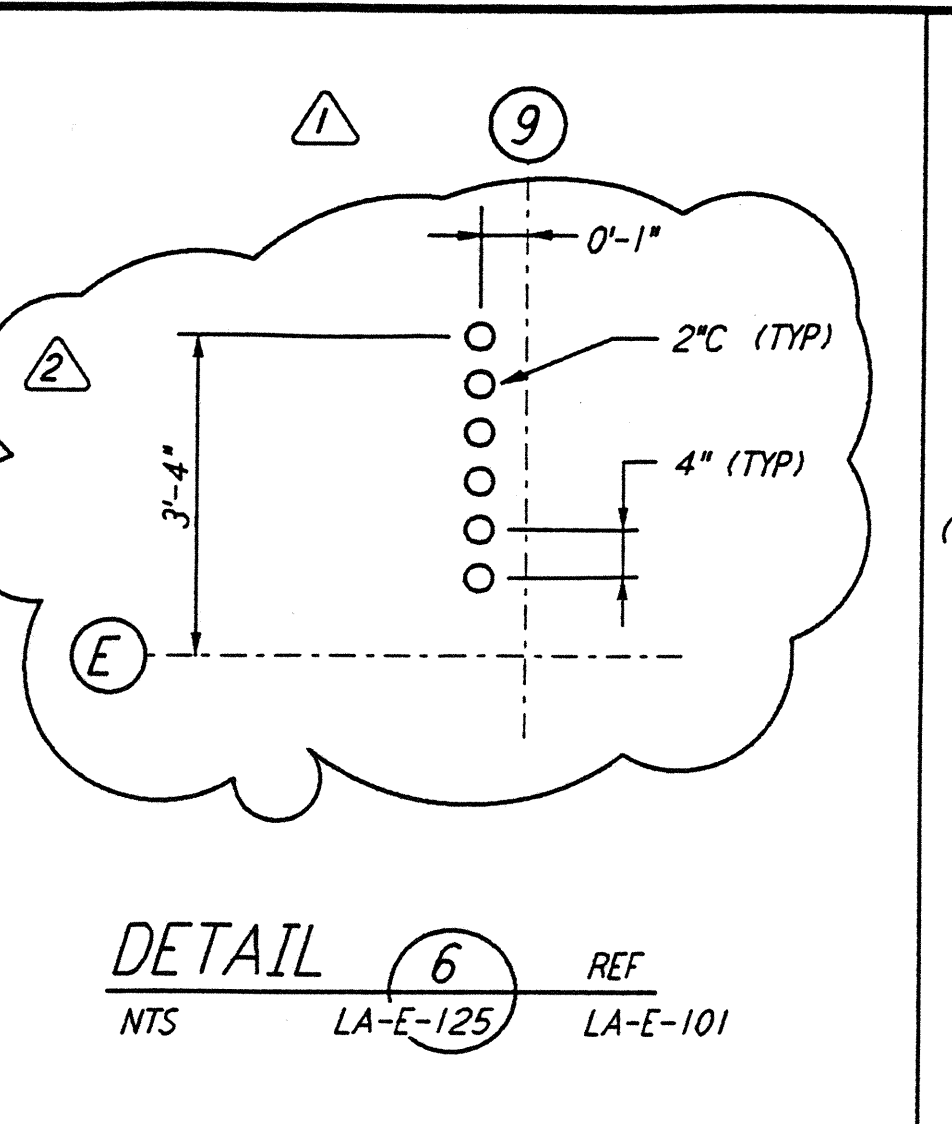


DETAIL 6 REF
 NTS LA-E-125 LA-E-101

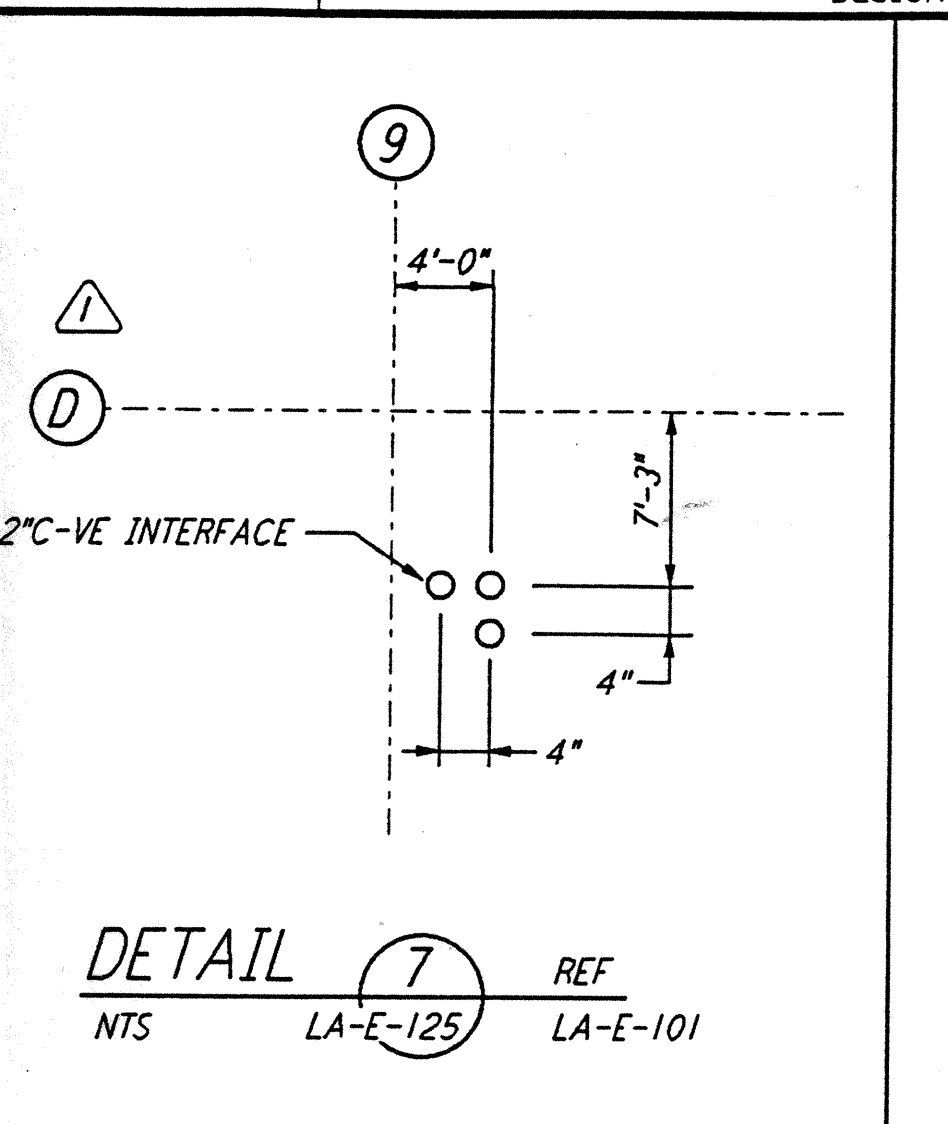


DETAIL 7 REF
 NTS LA-E-125 LA-E-101

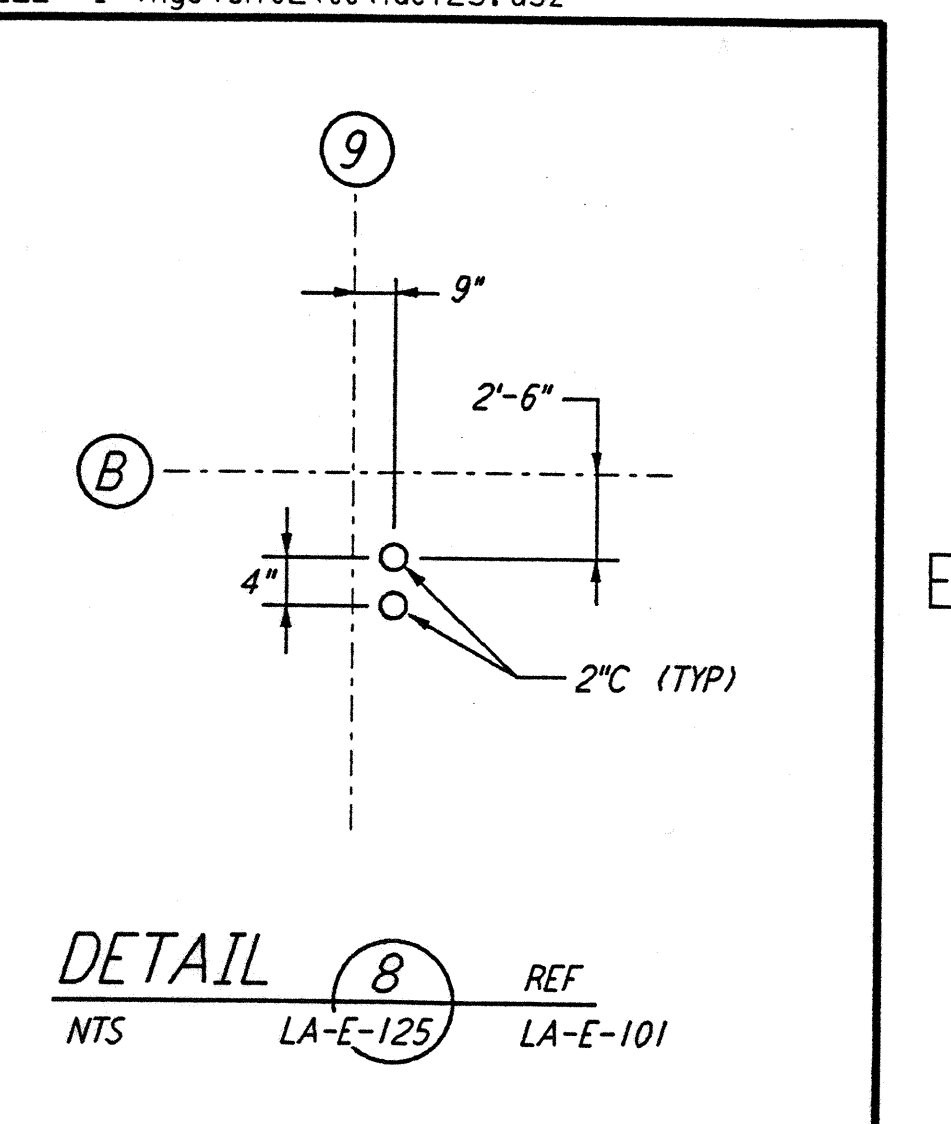


DETAIL 8 REF
 NTS LA-E-125 LA-E-101

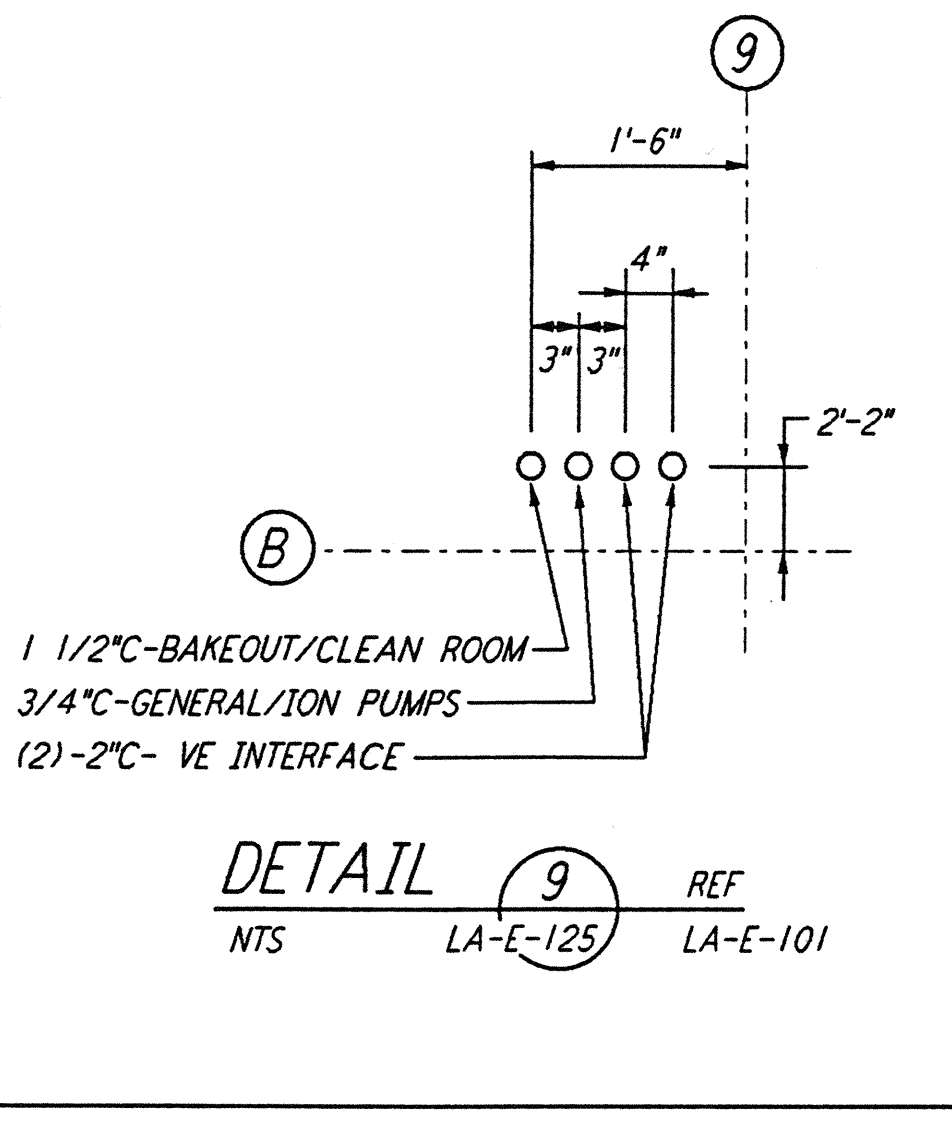


DETAIL 9 REF
 NTS LA-E-125 LA-E-101

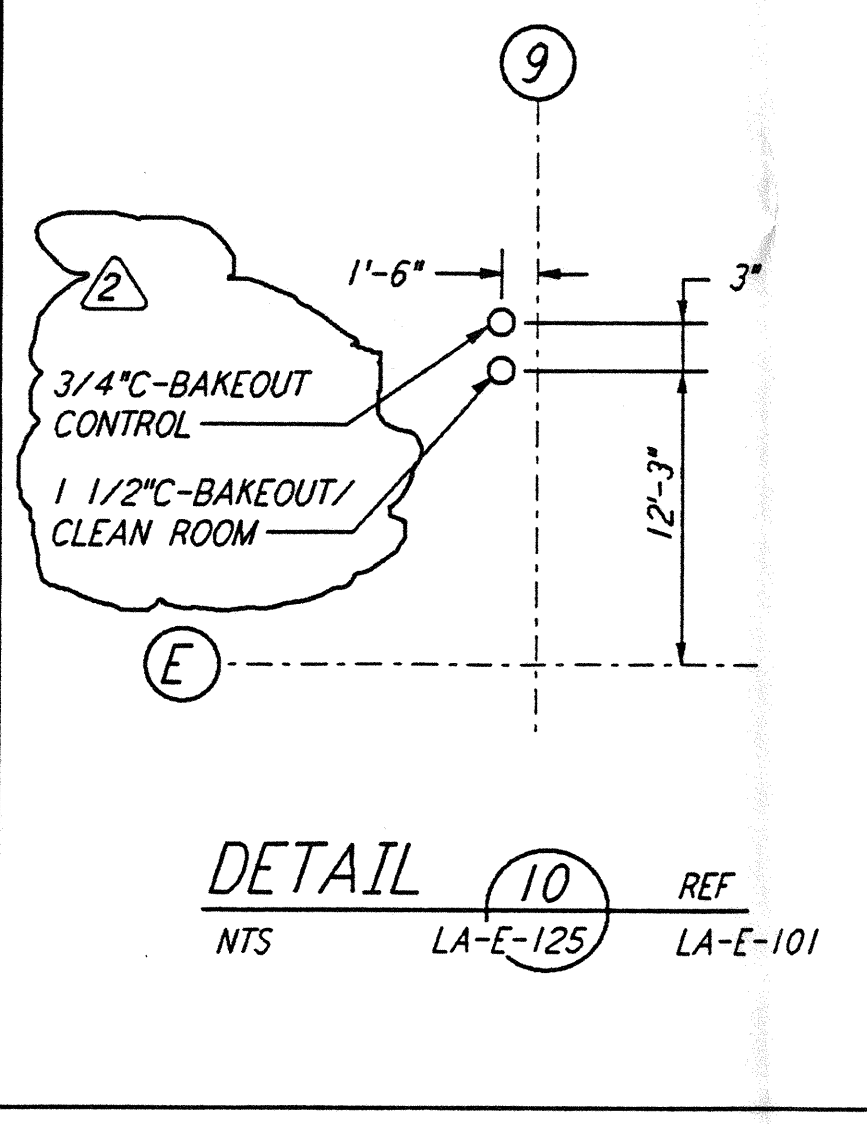


DETAIL 10 REF
 NTS LA-E-125 LA-E-101

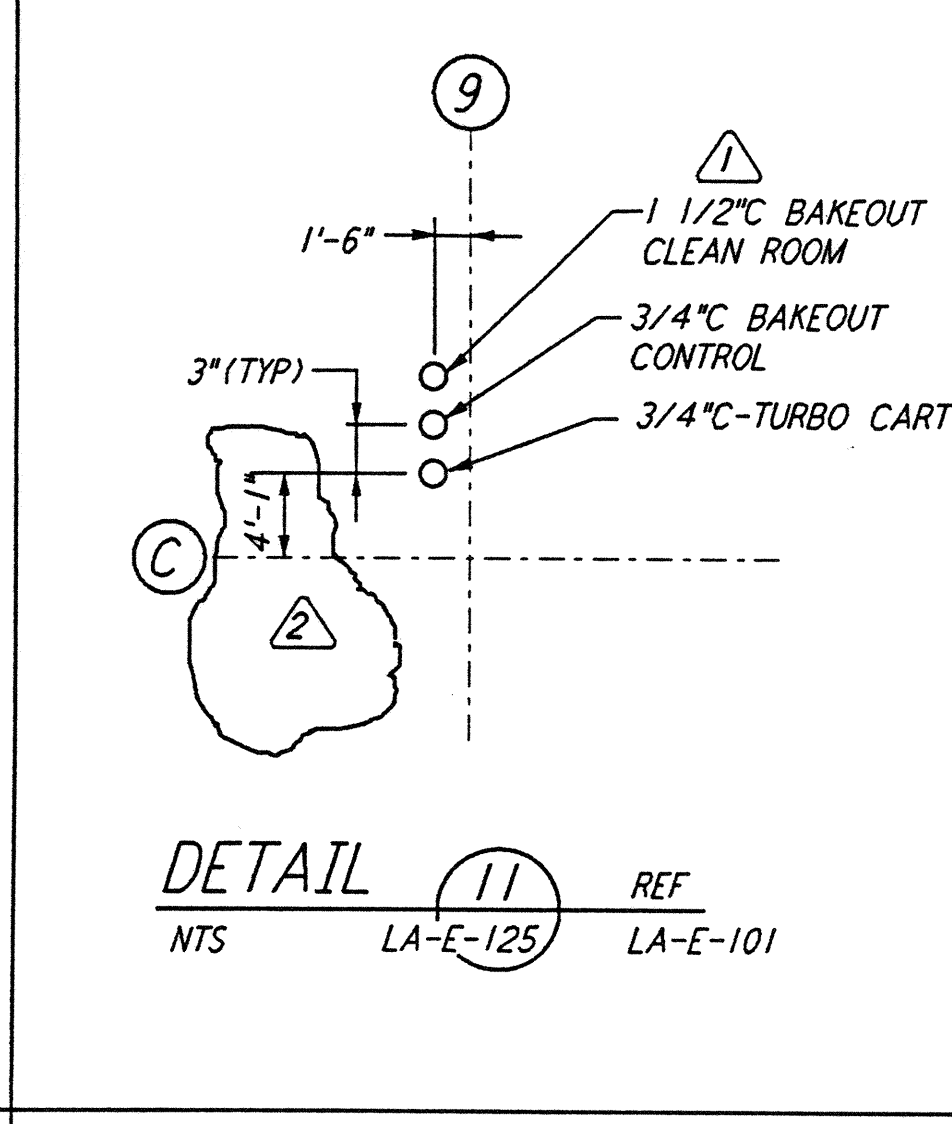


DETAIL 11 REF
 NTS LA-E-125 LA-E-101

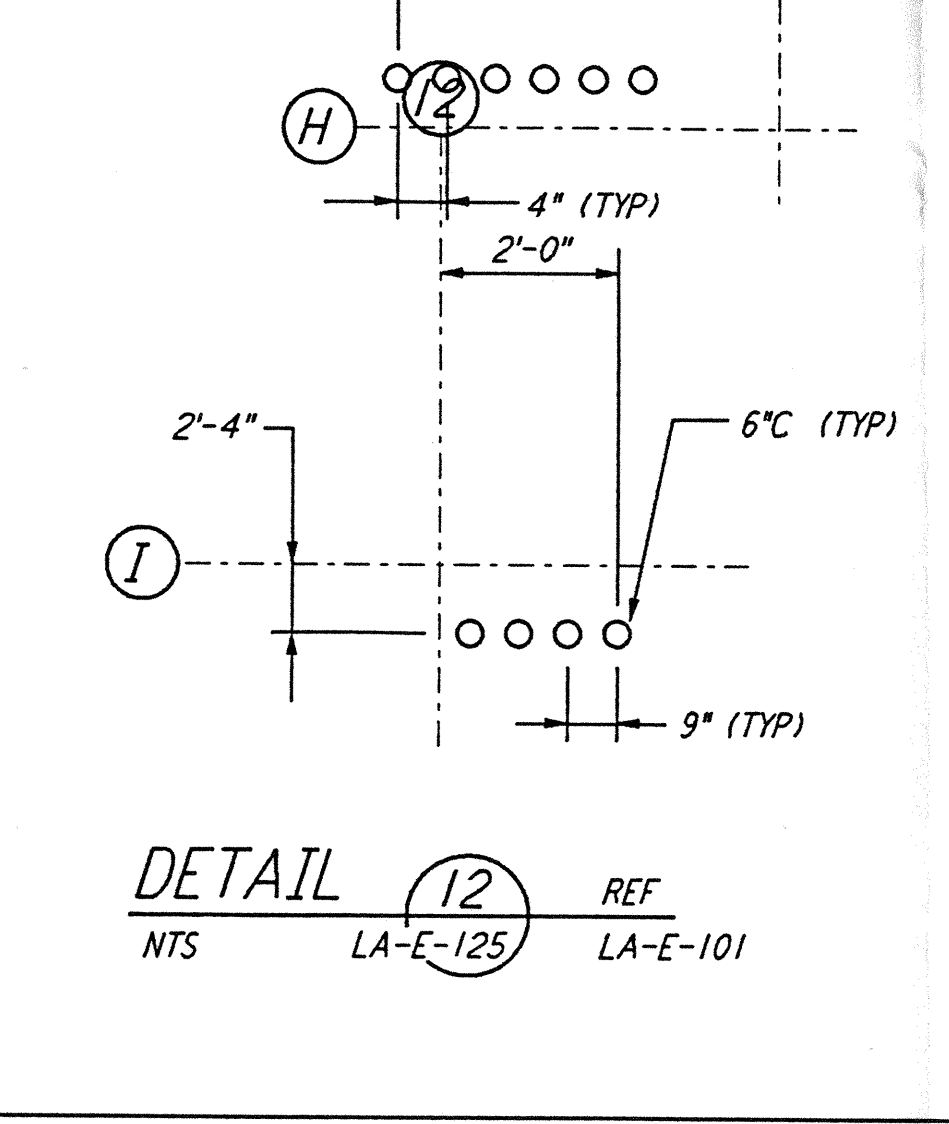


DETAIL 12 REF
 NTS LA-E-125 LA-E-101

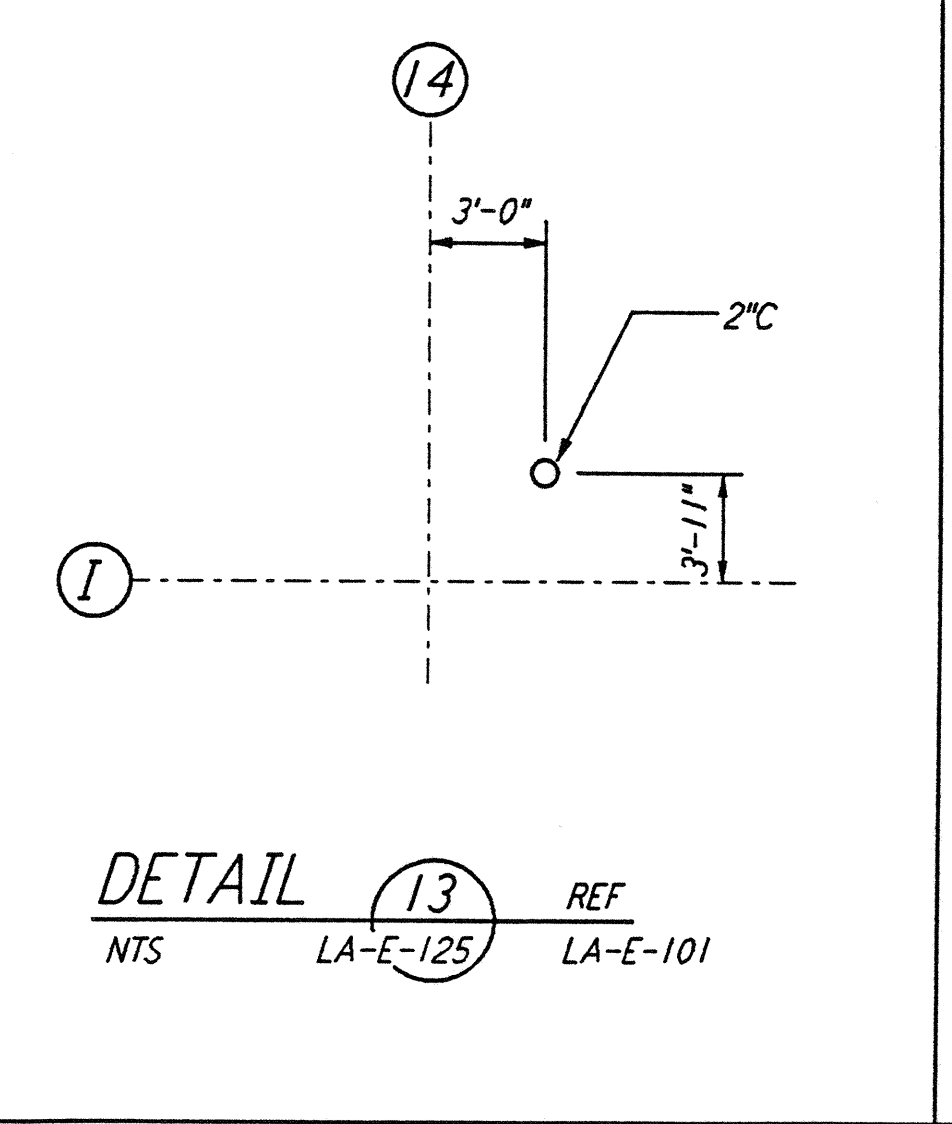


DETAIL 13 REF
 NTS LA-E-125 LA-E-101

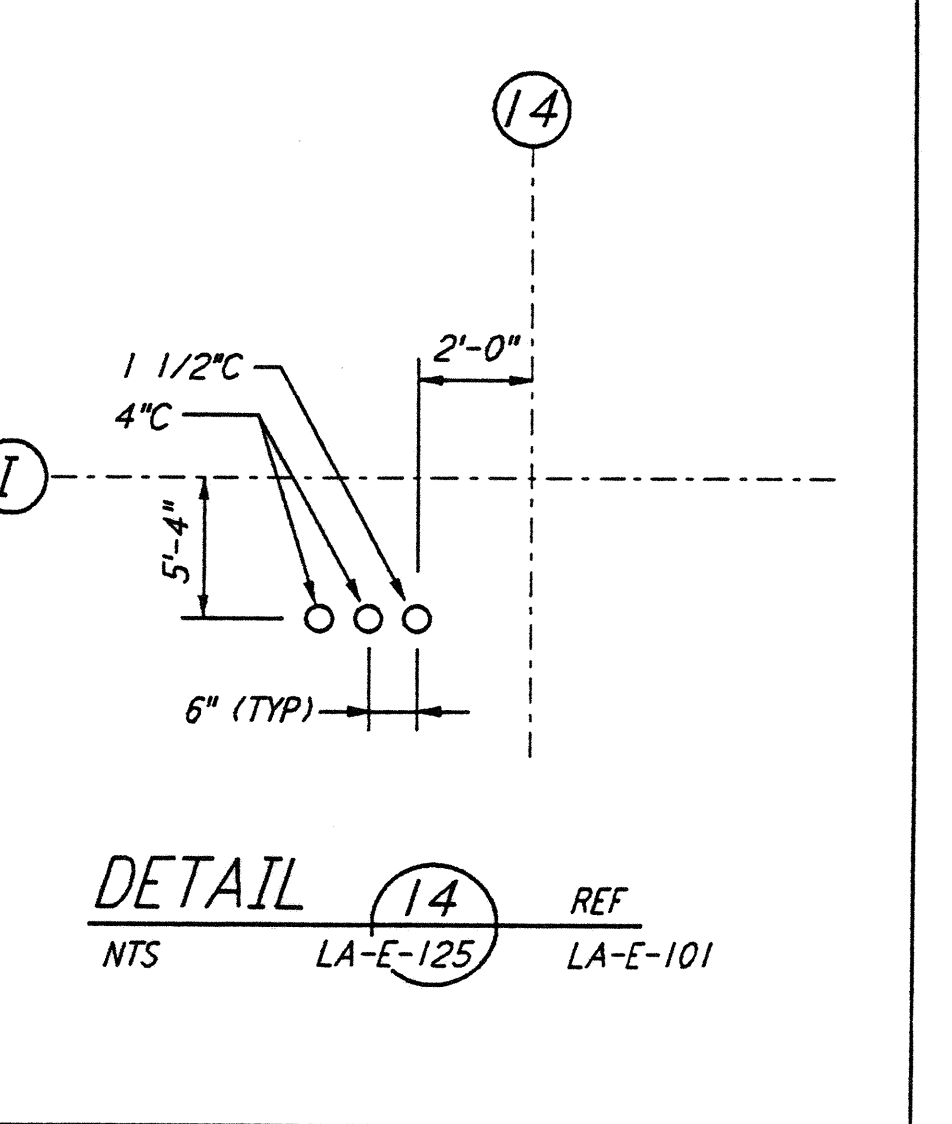


DETAIL 14 REF
 NTS LA-E-125 LA-E-101

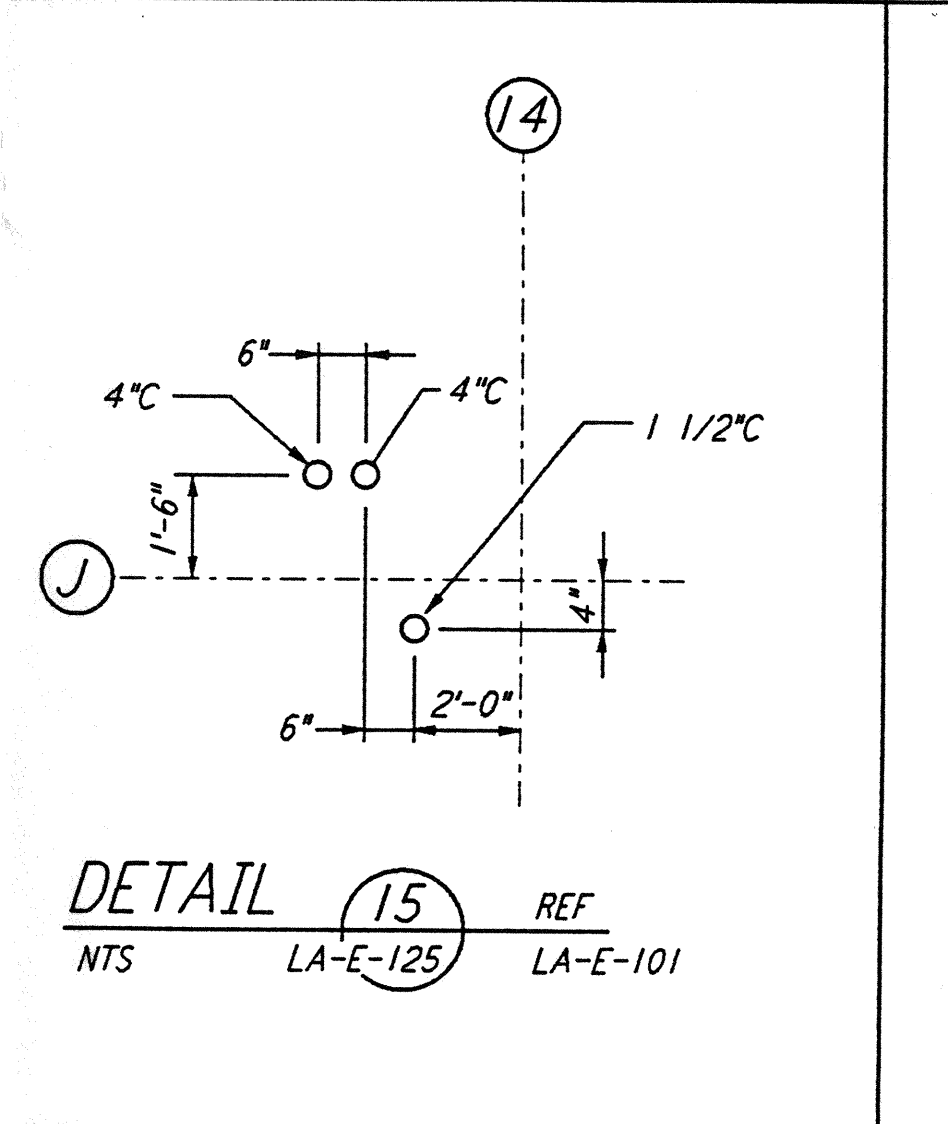


DETAIL 15 REF
 NTS LA-E-125 LA-E-101

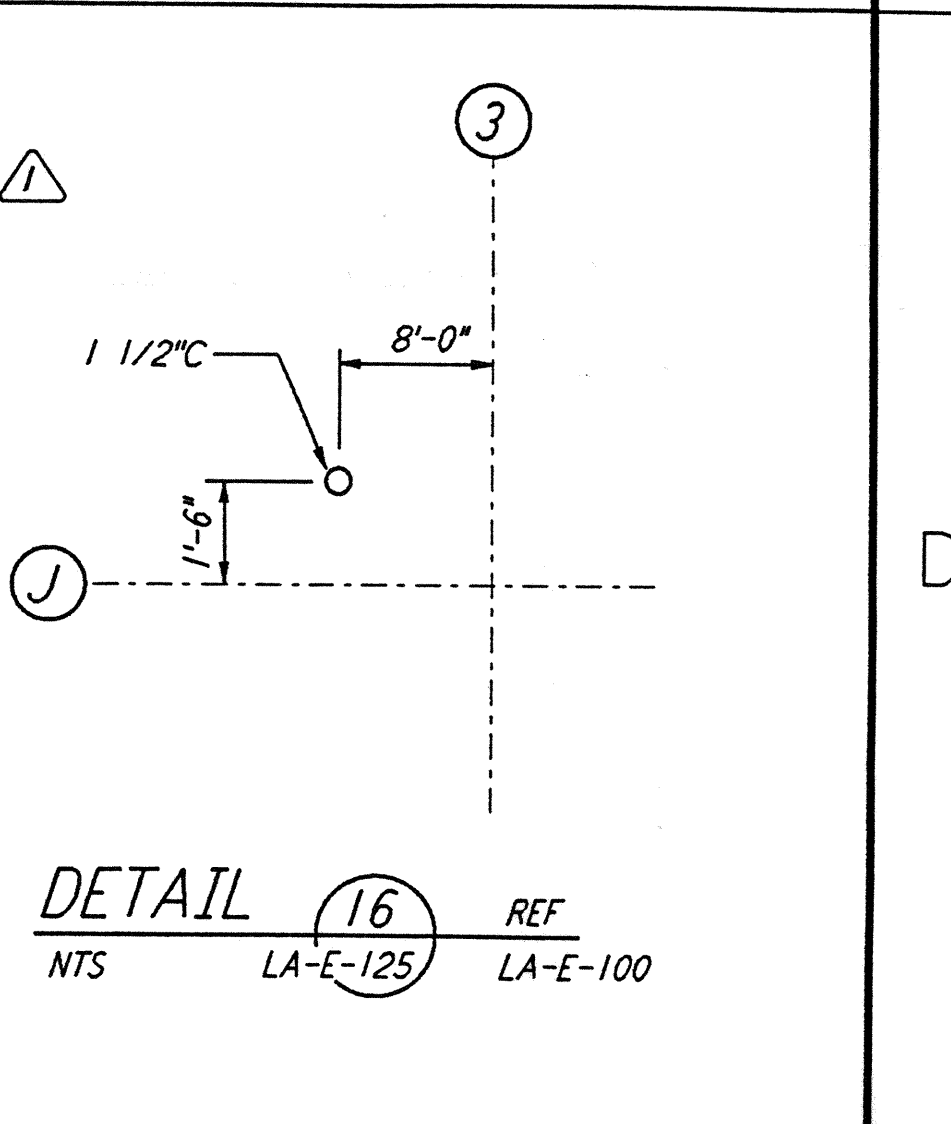


DETAIL 16 REF
 NTS LA-E-125 LA-E-100

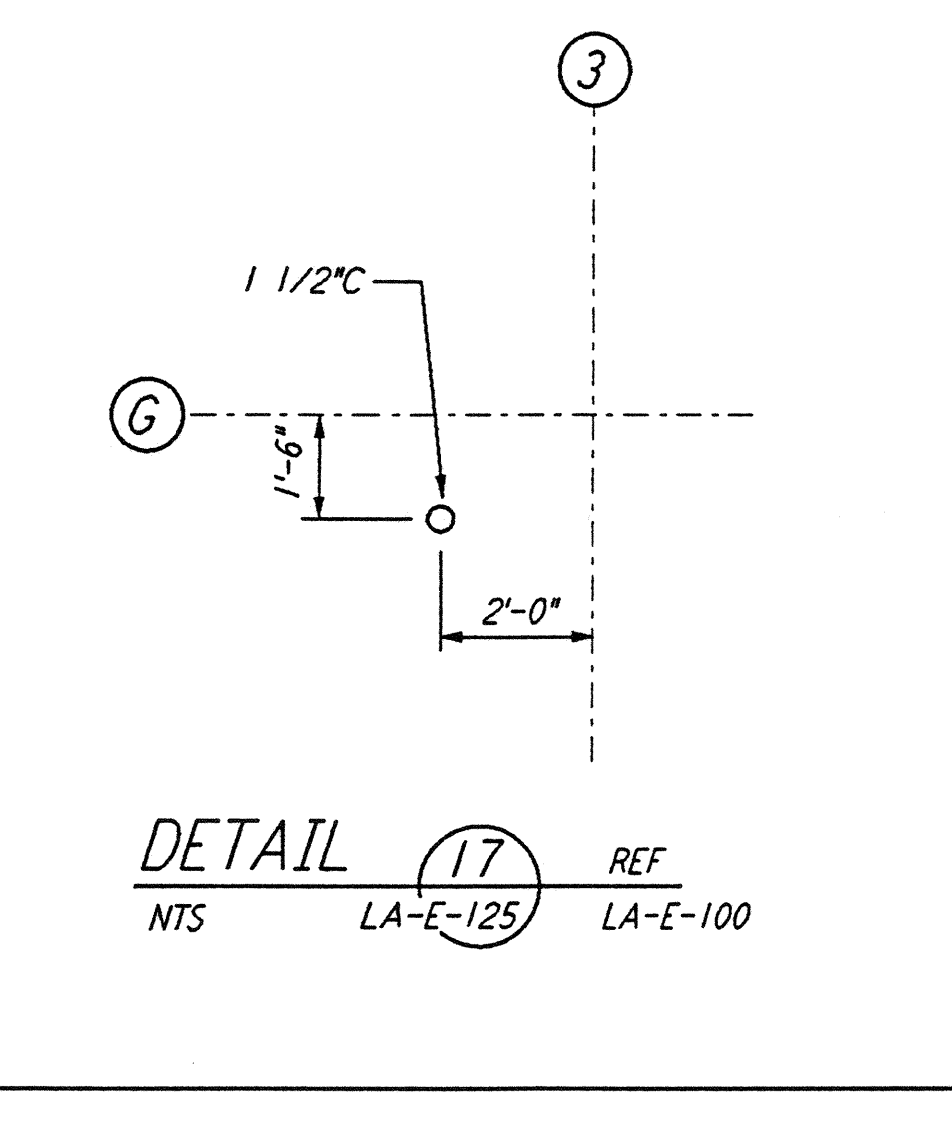


DETAIL 17 REF
 NTS LA-E-125 LA-E-100

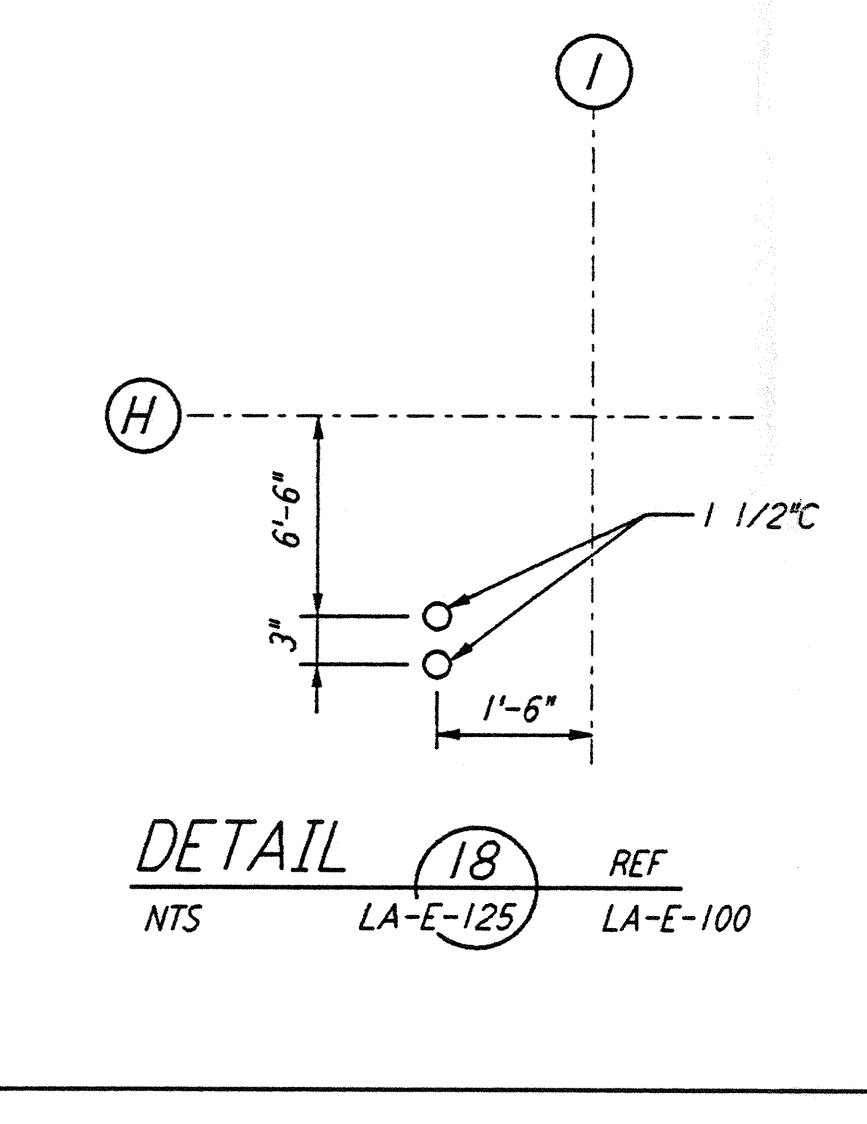


DETAIL 18 REF
 NTS LA-E-125 LA-E-100

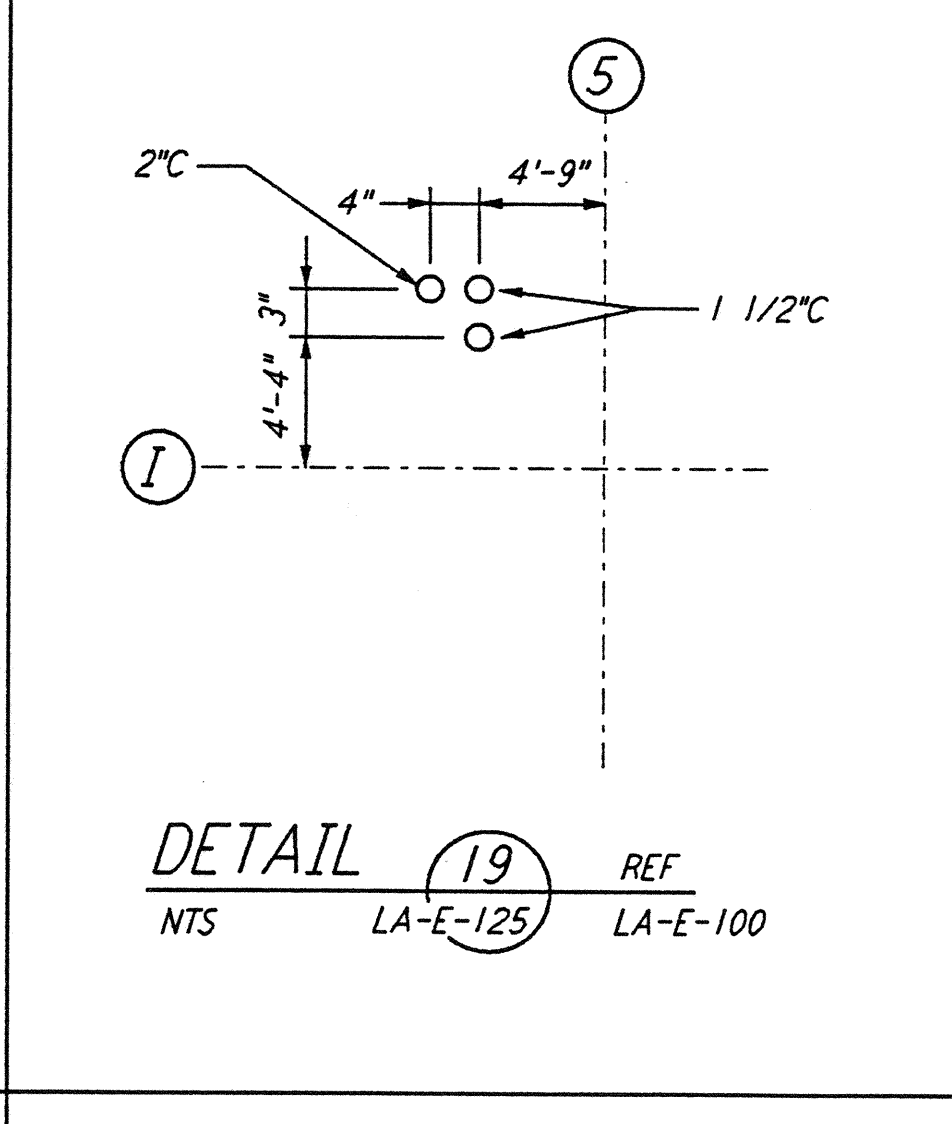


DETAIL 19 REF
 NTS LA-E-125 LA-E-100

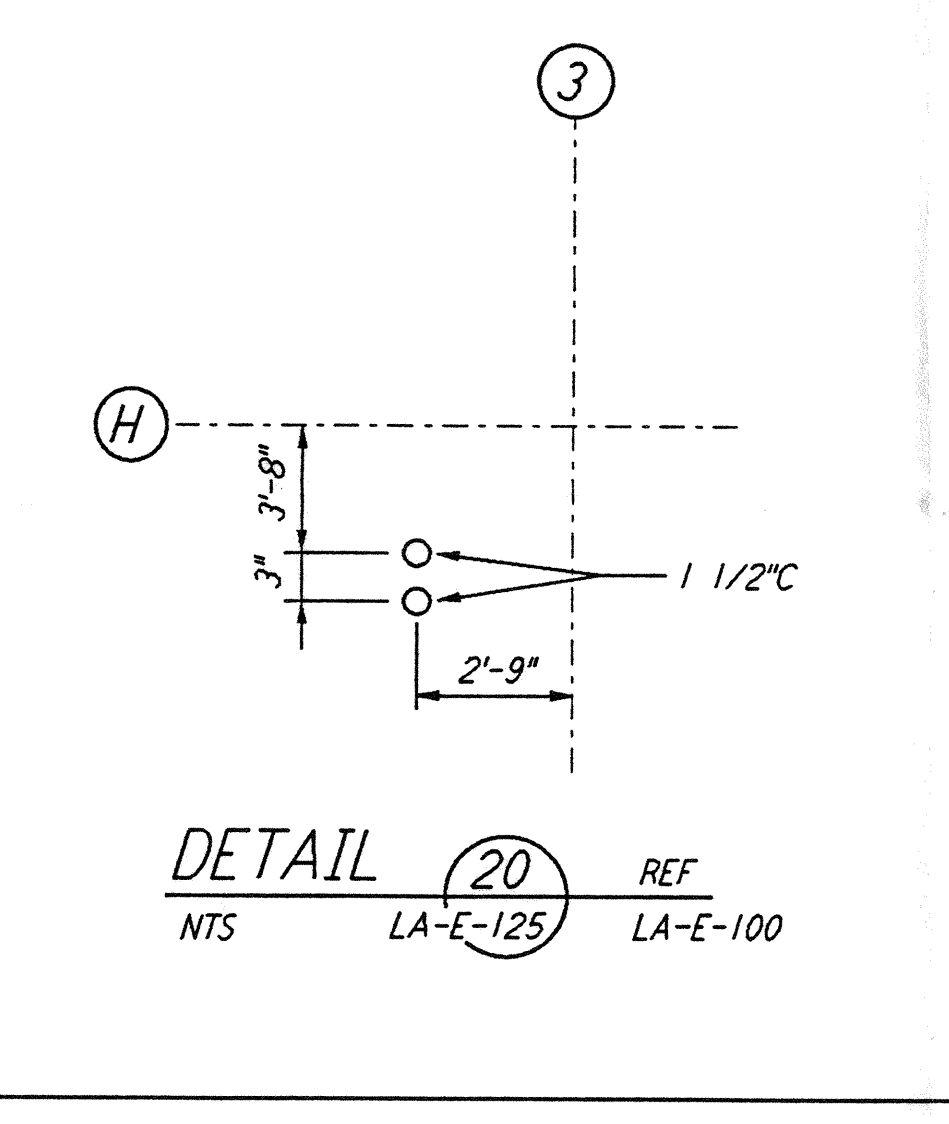


DETAIL 20 REF
 NTS LA-E-125 LA-E-100

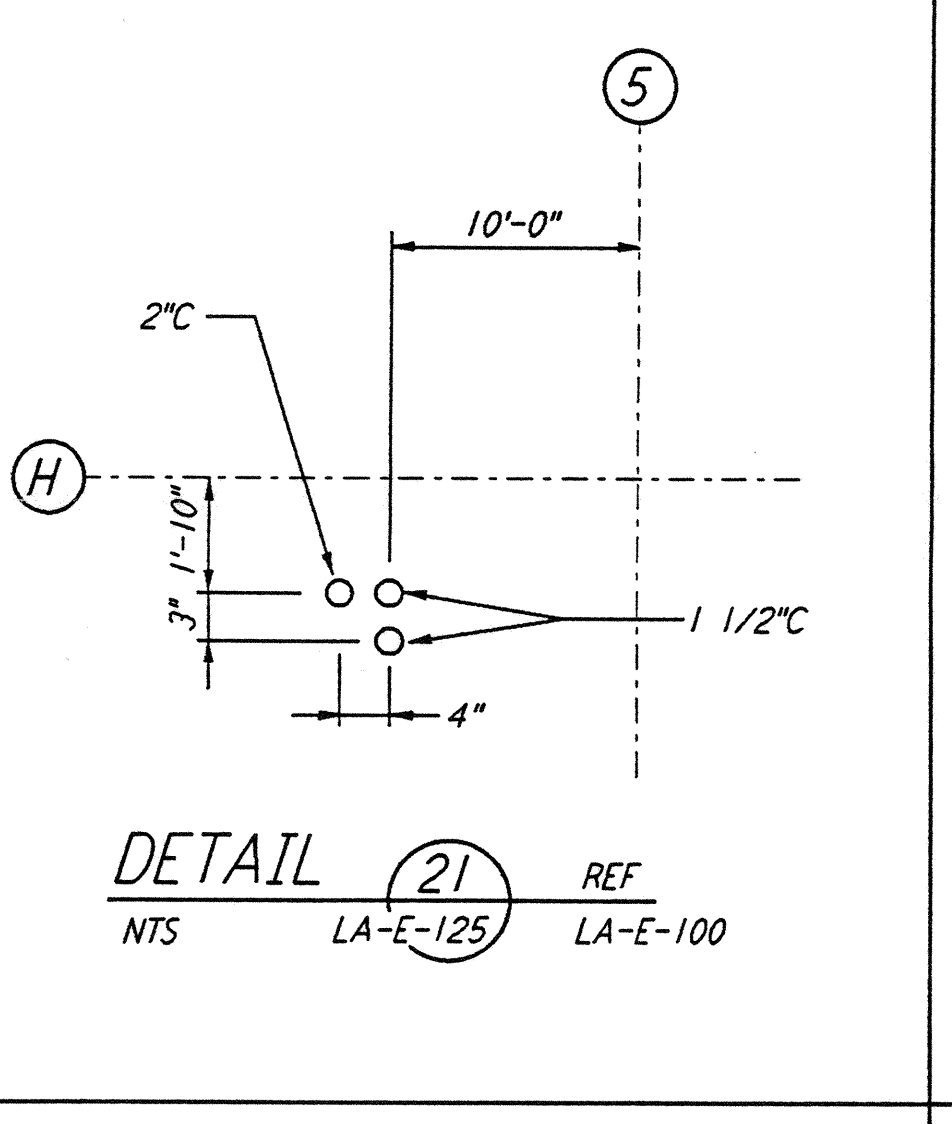


DETAIL 21 REF
 NTS LA-E-125 LA-E-100

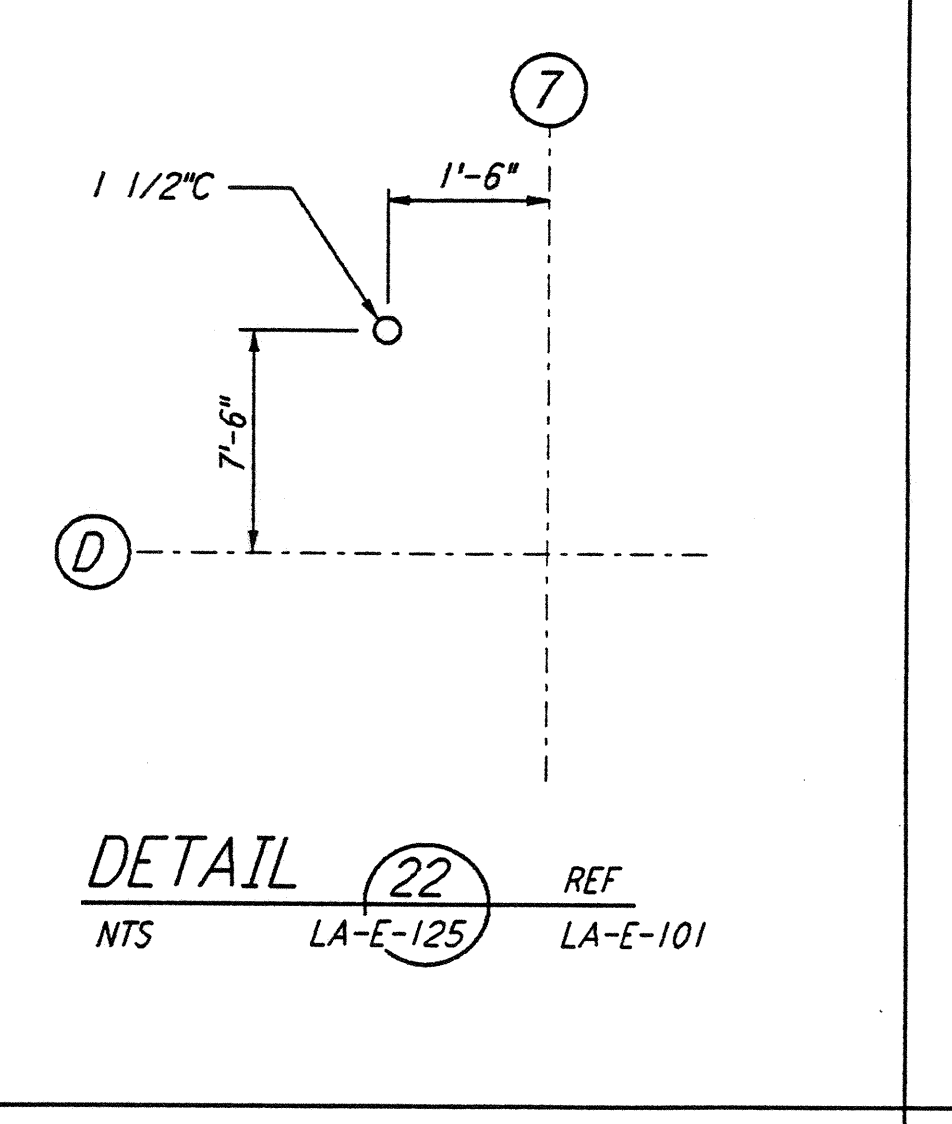


DETAIL 22 REF
 NTS LA-E-125 LA-E-101

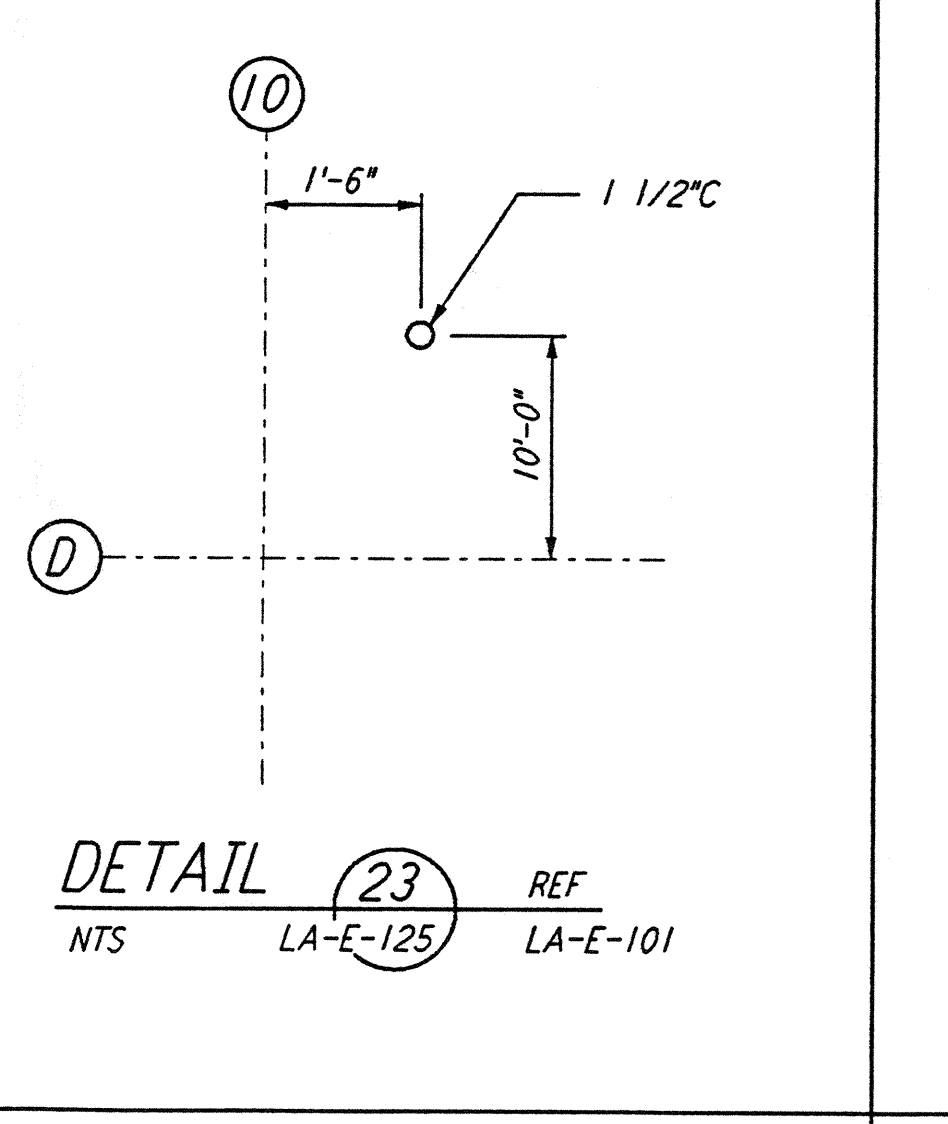


DETAIL 23 REF
 NTS LA-E-125 LA-E-101

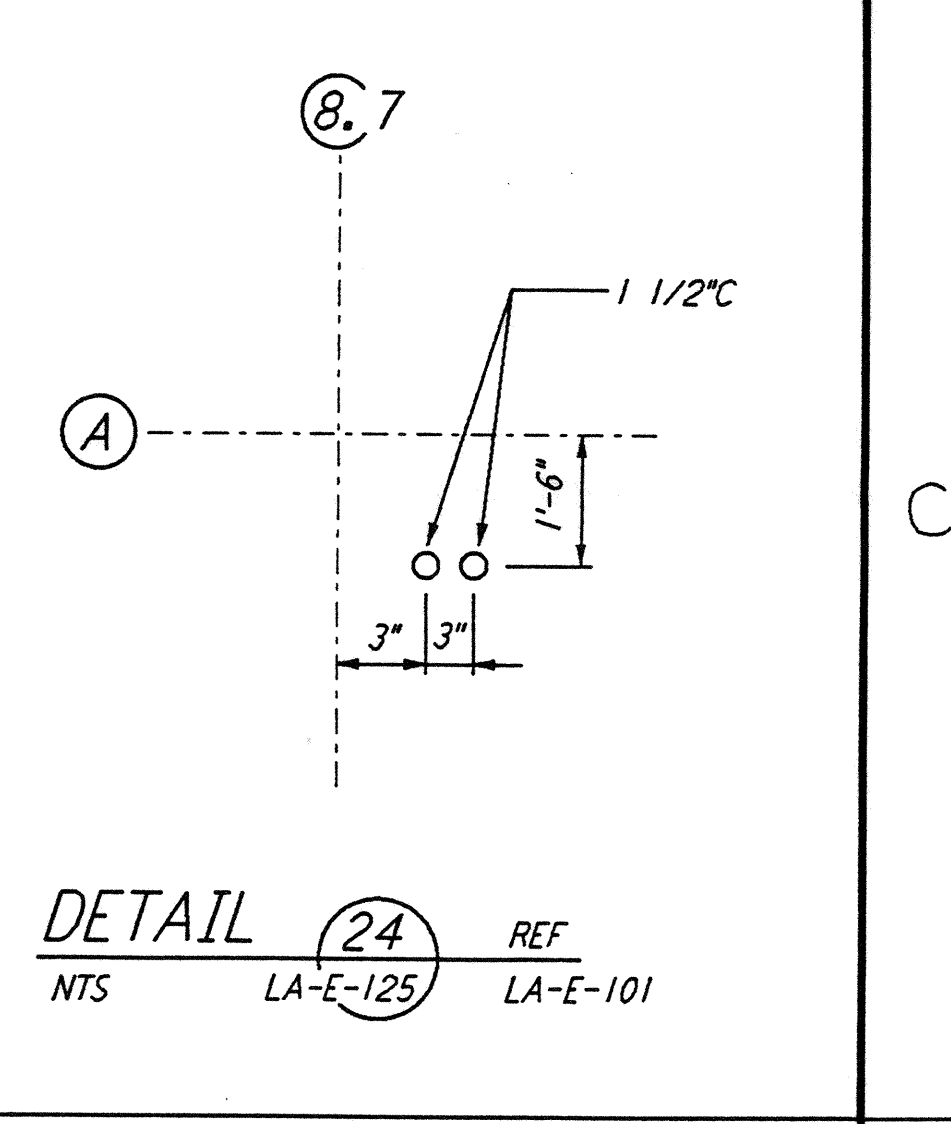


DETAIL 24 REF
 NTS LA-E-125 LA-E-101

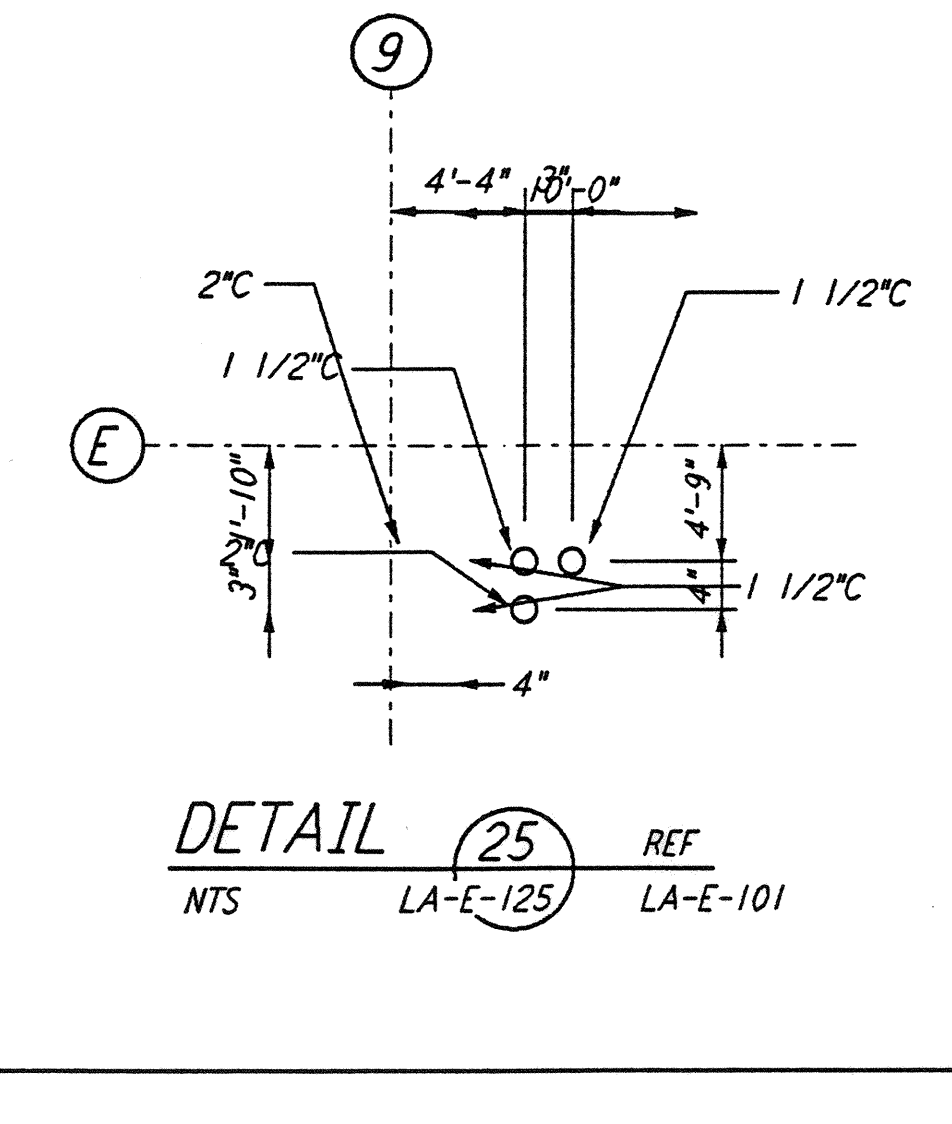

DETAIL 25 REF
 NTS LA-E-125 LA-E-101

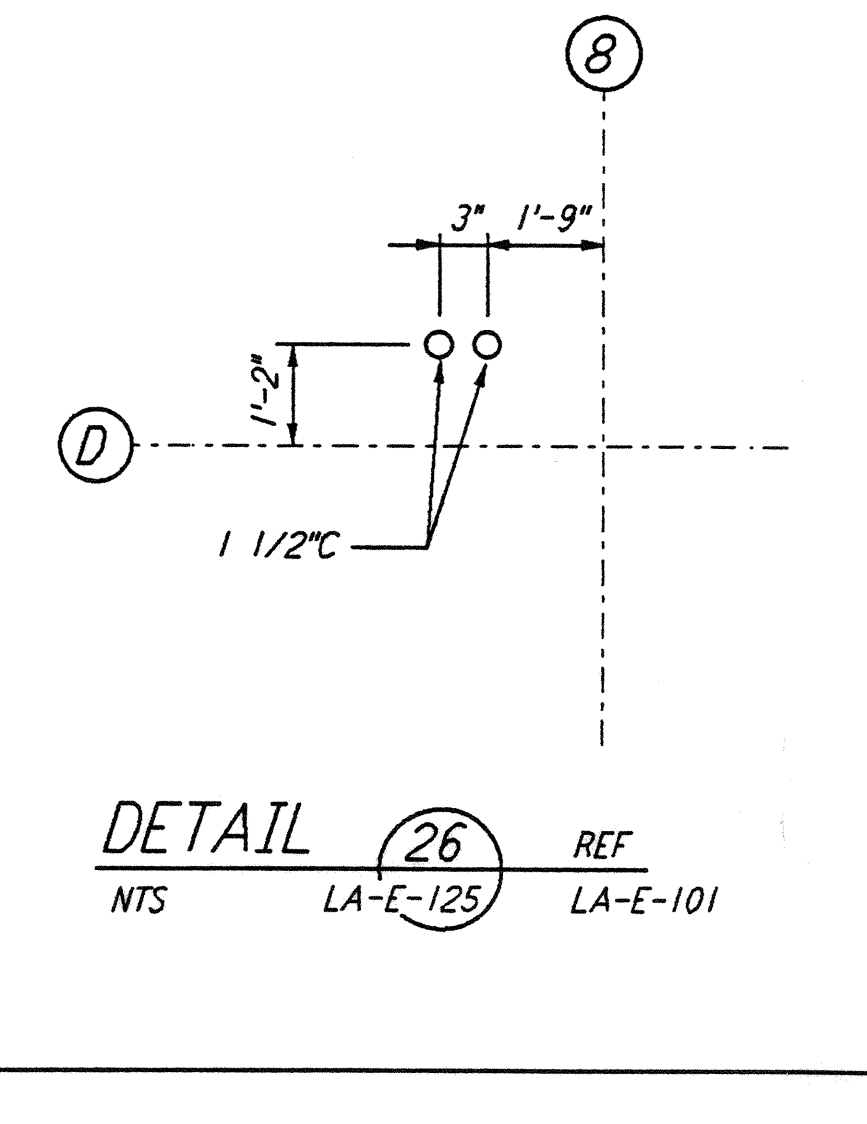

DETAIL 26 REF
 NTS LA-E-125 LA-E-101

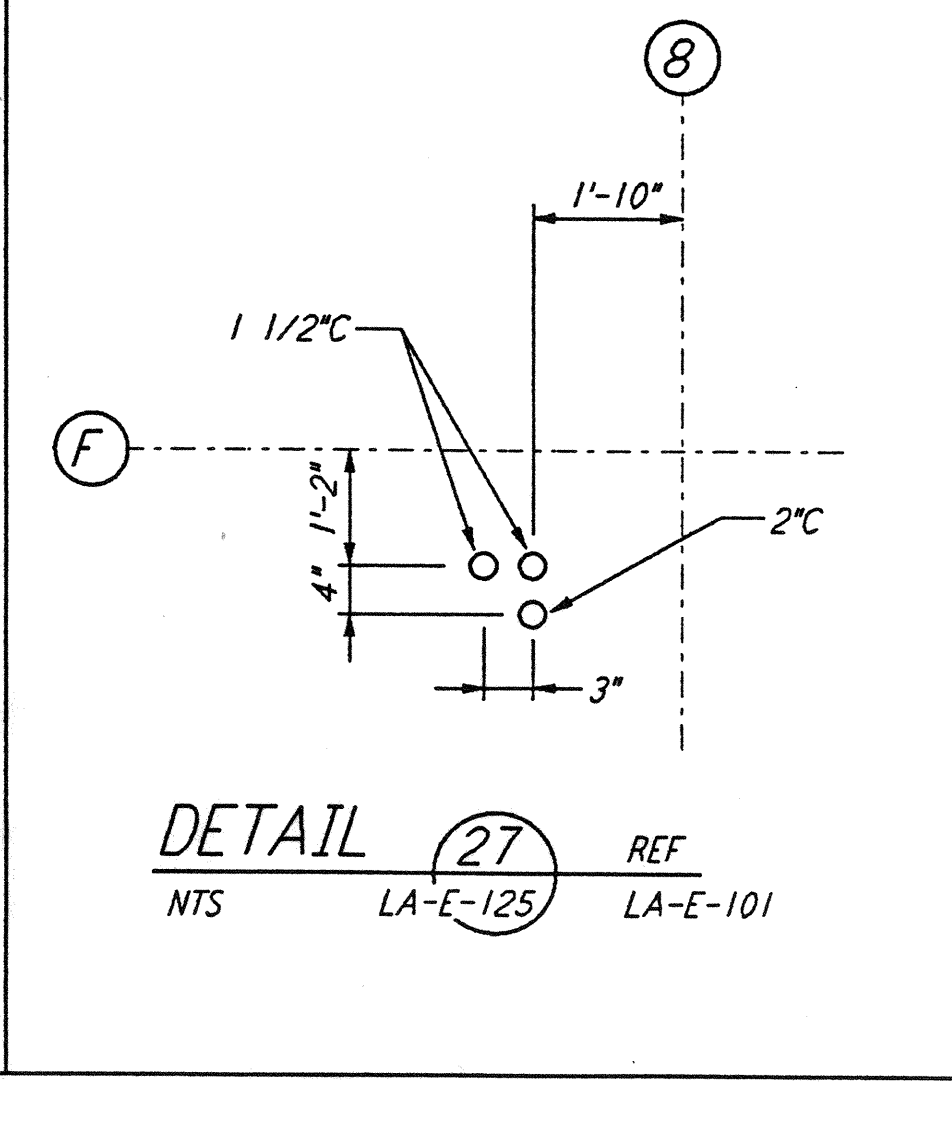


DETAIL 27 REF
 NTS LA-E-125 LA-E-101

NOTE: THE DETAILS ON SHEETS LA-E-123, LA-E-124 AND LA-E-125 SUPERSEDE, ENTIRELY THE DETAILS ON SHEET LA-E-114.

LIGO-D961481-02-0

NO.	DATE	BY	CHKD	ENGR	PROJ	DESCRIPTION
2	4-21-97	J. G.	KR	TDM		REVISED FOR CDS AND VAC. EQUIP.
1	4-4-97	J. G.	KR	TDM		GENERAL REVISIONS

ISSUED FOR CONSTRUCTION		
DRAWN	J. G.	3-21-97
CHECKED	B. K.	3-21-97
ENGINEER	K. C. R.	3-21-97
PROJ	T. D. M.	3-21-97

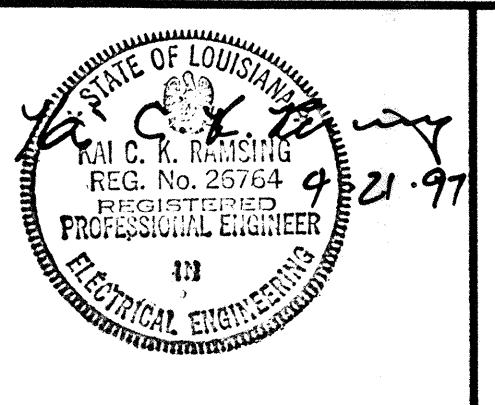

PARSONS
 100 WEST WALNUT STREET
 PASADENA, CALIFORNIA

LIGO
 CALIFORNIA INSTITUTE OF TECHNOLOGY
 MASSACHUSETTS INSTITUTE OF TECHNOLOGY

LASER INTERFEROMETER
 GRAVITATIONAL-WAVE OBSERVATORY
 SITE NO. 2 - LIVINGSTON, LOUISIANA

TITLE	SCALE	CONTRACT NUMBER	PROJECT NUMBER
ELECTRICAL CORNER STATION	NONE	PP150969	8094
LVEA AREAS 101, 102, 103, 104			
DETAILS			

LA-E-125

100 West Walnut Street Pasadena, CA 91106-1000