
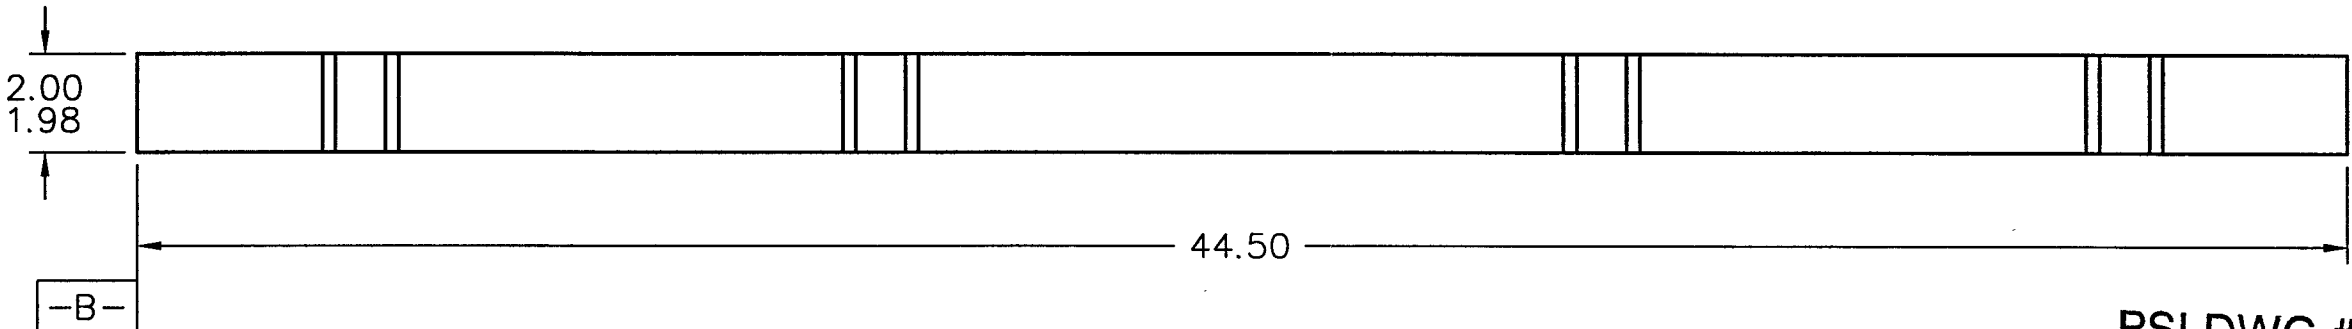


REVISIONS			
REV.	DESCRIPTION	APPROVED	DATE
A	RELEASED		
B	REMOVE No.4 FINISH		2-8-96
C	ADDED VENT NOTCHES	AJL	7-23-96
D	.03 DIM WAS .125; ADDED .26 DIM	AJL	9/18/96
E	3.735 WAS 3.750	AJL	10-28-96

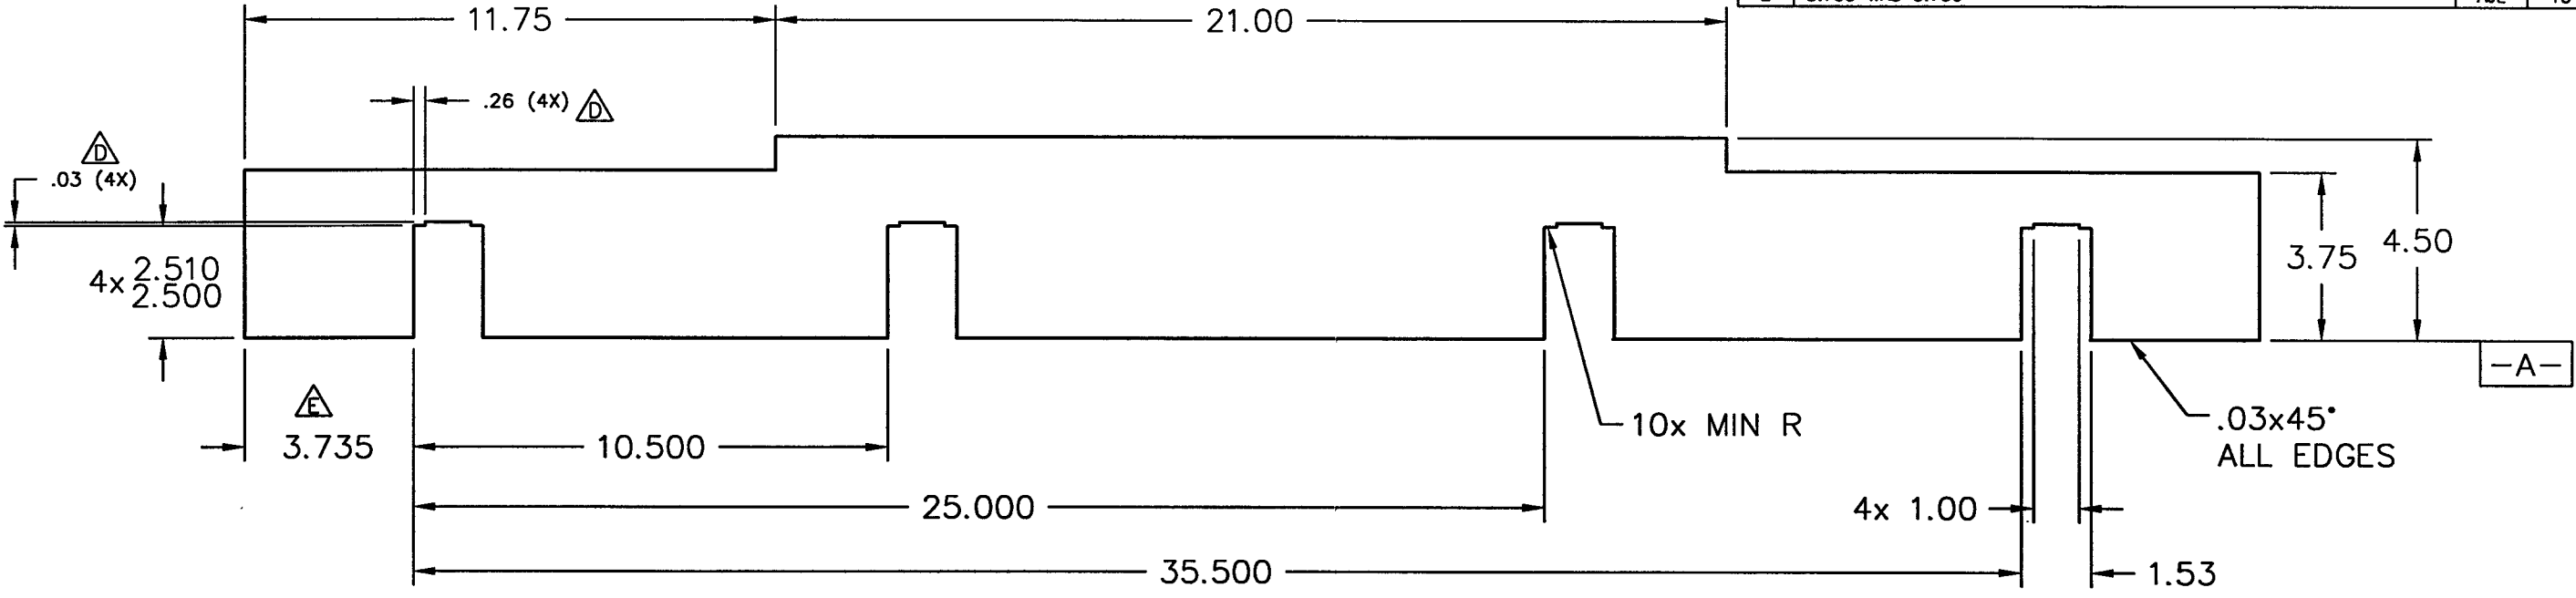

DEC 19 1996

L140-D961591-E-V

PSI DWG # V049-8-151

ITEM	QTY.	PART NO.	DESCRIPTION
			BAR, 2.00 THK, 4.50 WD, 44.50 LG

PART LIST		MATERIAL SPECIFICATION 304L SST	
<small>UNLESS OTHERWISE SPECIFIED: DIMENSIONS ARE IN INCHES TOLERANCES ARE: DECIMALS ANGLES FINISH .XX ± .01 ± 10° 125/ XXX ± .005 //, C, L WITHIN .05 UNSPECIFIED FILLETS: R.015 BREAK EDGES 2ND & 4TH REMOVE ALL BURRS</small>		<small>CONTRACT OR SALES ORDER NO.</small> <small>APPR. NO.</small> 120# <small>110#</small> <small>APPROVALS</small> <small>DATE</small>	

GNB Corporation
SCIENTIFIC AND INDUSTRIAL EQUIPMENT
30071 San Benito Court
HAYWARD, CALIFORNIA 94544
(510) 441-1900 FAX: (510) 441-0930

TITLE **INTER. CROSS MEMBER**
G44

D103236	DO NOT SCALE DRAWING	ENGINEER ZH	1-24-95	B	DWG. NO. 103247	REV. E
USED ON	B103247E		SCALE: NONE	SHEET 1 OF 1		

NOTES:
PROTECT ALL SURFACES FROM SCRATCHES,
GOUGES AND TOOLING MARKS DURING HANDLING