
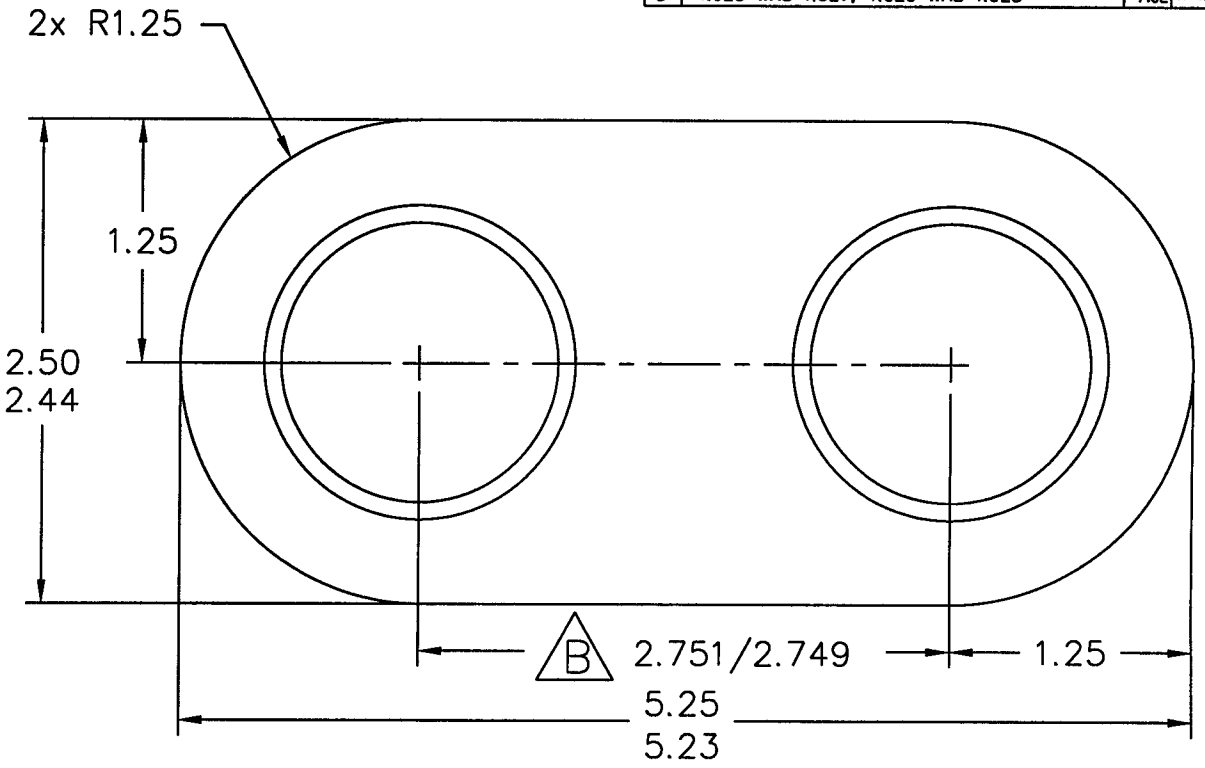


REV	DESCRIPTION	APPROVED	DATE
A	RELEASED		
B	TIGHTENED TOLERANCE ON FLATNESS AND PARALLELISM AND C-C DIST. OF HOLES	AJL	9/6/96
C	RELOCATED FLATNESS AND PARALLELISM CALLOUTS	AJL	11-14-96
D	1.628 WAS 1.627; 1.626 WAS 1.625	AJL	11-18-96

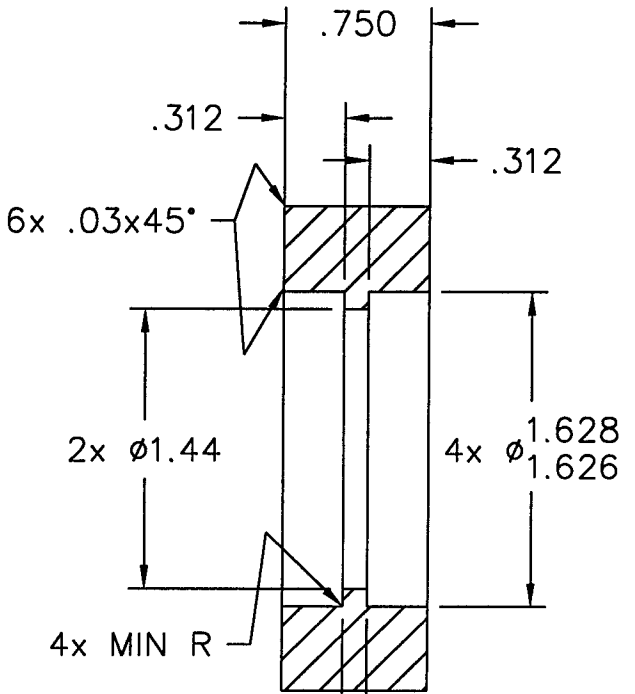

	.005		.002	A
		-A-		

DEC 19 1996

PSI DWG # V049-8-500

NOTES:

- ① FINAL CLEANING TO MEET GNG SPEC. PER UHV

ITEM	QTY.	PART NO.	DESCRIPTION
			BAR, .88 THK, 2.50 WD, 5.25 LG
PART LIST		MATERIAL SPECIFICATION T304L SST	
UNLESS OTHERWISE SPECIFIED DIMENSIONS ARE IN INCHES TOLERANCES ARE: DECIMALS ANGLES FRACTIONS ±.01 ±1° 125/1000 ±.005		CONTRACT OR SALES ORDER NO. APPROX. WT. 2# APPROVALS DATE	
THIRD ANGLE PROJECTION 		 GNB Corporation SCIENTIFIC AND INDUSTRIAL EQUIPMENT 30971 San Benito Court HAYWARD, CALIFORNIA 94544 (510) 441-1900 FAX: (510) 441-0939	
DO NOT SCALE DRAWING		ENGINEER ZH 1-27-96	
CADD FILE NAME A103241D		SCALE: NONE SHEET 1 OF 1	

LIGO-D961616-D-V